


Survey for Kenneth Marchison
 207 Lake Street
 La Grande, Oregon

Date -- October 9, 1963

cont. ~~Map of 380~~ ~~to place~~ ~~of~~ ~~Park Ave~~



Scale 1" = 100'

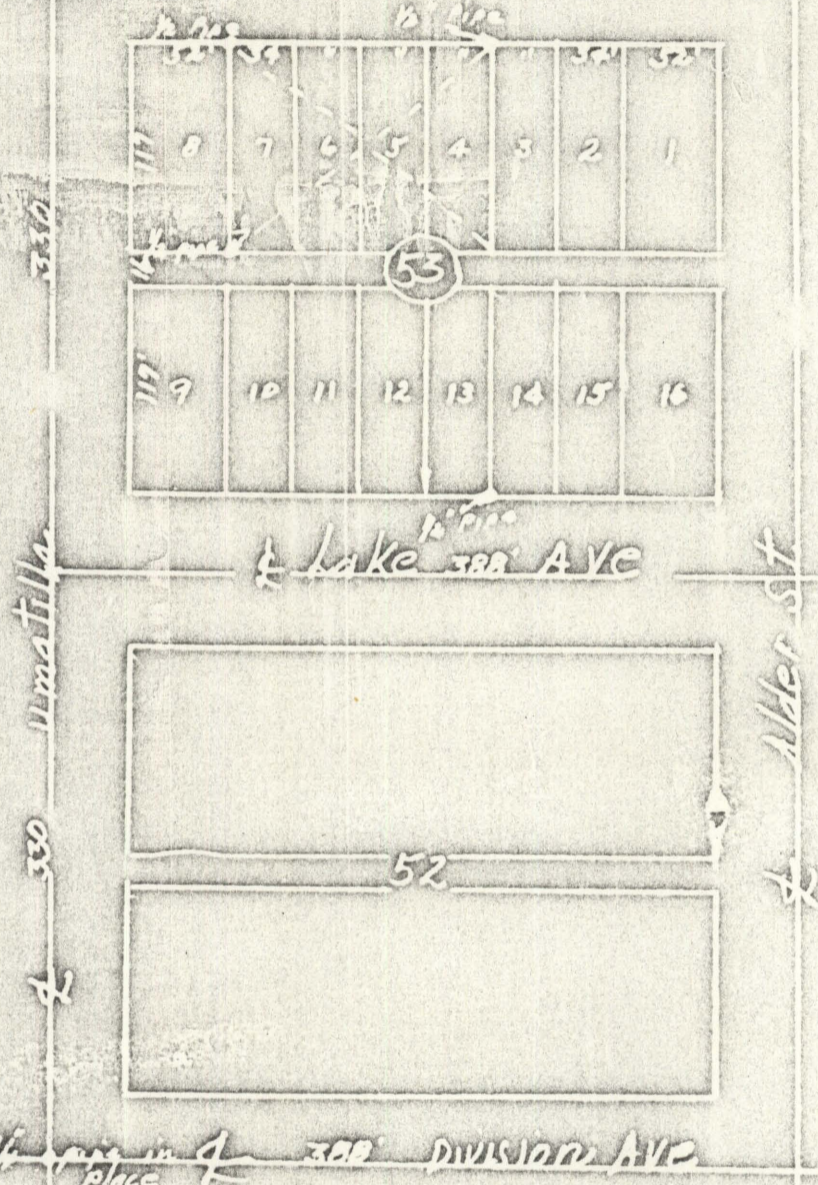

Description of survey:

To establish NW and SE corners of lot 7 and NE corner of Lot 4 and SE corner of lot 13 of Block 53 of Riverside Addition to La Grande, Union County, Oregon.

REGISTERED
 OREGON
 LAND SURVEYOR
James G. Vollen
 MAY 4, 1966
 JAMES G. VOLLEN
 381

28-1963

2863