

LEGEND



- FOUND MONUMENT OF RECORD
- SET 5/8" x 30" STEEL PIN WITH CAP MARKED A-P&A
- () RECORD DEED DATA
- EXISTING FENCE

REFERENCE MATERIAL

RECORD SURVEYS: # 17
19
61-73
24-77

NOTE:
BE ADVISED THAT THE MONUMENT LOCATIONS ESTABLISHED AROUND THE "BLOMBERG PARCEL" BY THIS SURVEY ARE INCORRECT. THEIR POSITIONS WERE BASED ON THE SOUTH 1/4 CORNER OF SEC. 32 AS RE-ESTABLISHED BY THE OREGON STATE HIGHWAY DEPT. THIS HIGHWAY DEPT. MONUMENT HAS SINCE BEEN PROVEN TO BE INCORRECTLY LOCATED.

DEC. 29, 1983 ANDERSON-PERRY & ASSOC.
Gary L. Doughty LS 1099

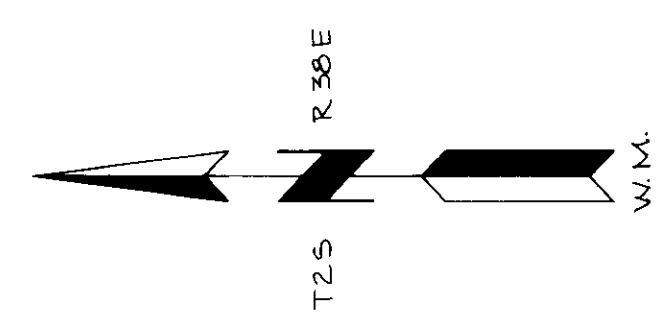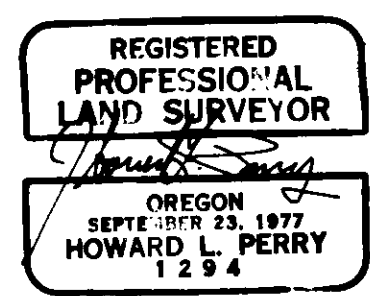

BASIS OF BEARING
RECORD SURVEY 24-77

MAP OF SURVEY - A PARCEL OF LAND SITUATED IN THE SE 1/4 OF THE SW 1/4 OF SECTION 32, T2S, R38E, W.M. UNION COUNTY OREGON	
FOR: BARBARA BLOMBERG	
SCALE 1" = 50'	<p>anderson perry & associates, inc. engineering • surveying • materials testing LA GRANDE & ENTERPRISE, OREGON</p>
DATE OCT. 1978	
SHEET NO. 1	

135-78