


LEGEND

- FOUND MONUMENT OF RECORD
- 5/8" x 30" PIN W/CAP MARKED AP & A SET ON RECORD SURVEY # 10-78
- SET 5/8" x 30" PIN W/CAP MARKED AP & A
- () RECORD DATA
- ③ BLOCK NUMBER

REFERENCE MATERIAL

- RECORD SURVEYS:
- * 79
 - * 11-61
 - * 73-70
 - * 23-71
- ORIGINAL PLAT OF HONAN'S ADDITION TO LA GRANDE

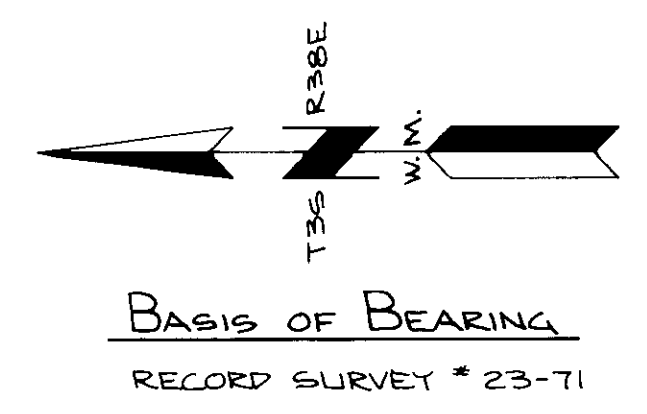

REGISTERED PROFESSIONAL LAND SURVEYOR

OREGON
SEPTEMBER 23, 1977
HOWARD L. PERRY
1294

AMENDMENT TO SURVEY # 10-78

LOTS 1 & 4 OF BLK. 3 AND A PORTION OF "O" AVENUE OF HONAN'S ADDITION TO LAGRANDE, OREGON

FOR: FOREST INVESTMENT CORP.

SCALE: 1" = 40'

DATE: 1978

SHEET NO. 1

Anderson & Perry Associates, Inc.
engineering • surveying • materials testing
LAGRANDE & ENTERPRISE, OREGON

136-78