


BASIS OF BEARING

SOLAR OBSERVATION
AS PER RECORD
SURVEY 19-70

LEGEND

- ⊕ FOUND MONUMENT OF RECORD AS SHOWN
- SET 5/8" x 30" STEEL PIN W/CAP MARKED AP&A
- *—*— EXISTING FENCE
- () DEED RECORD DATA

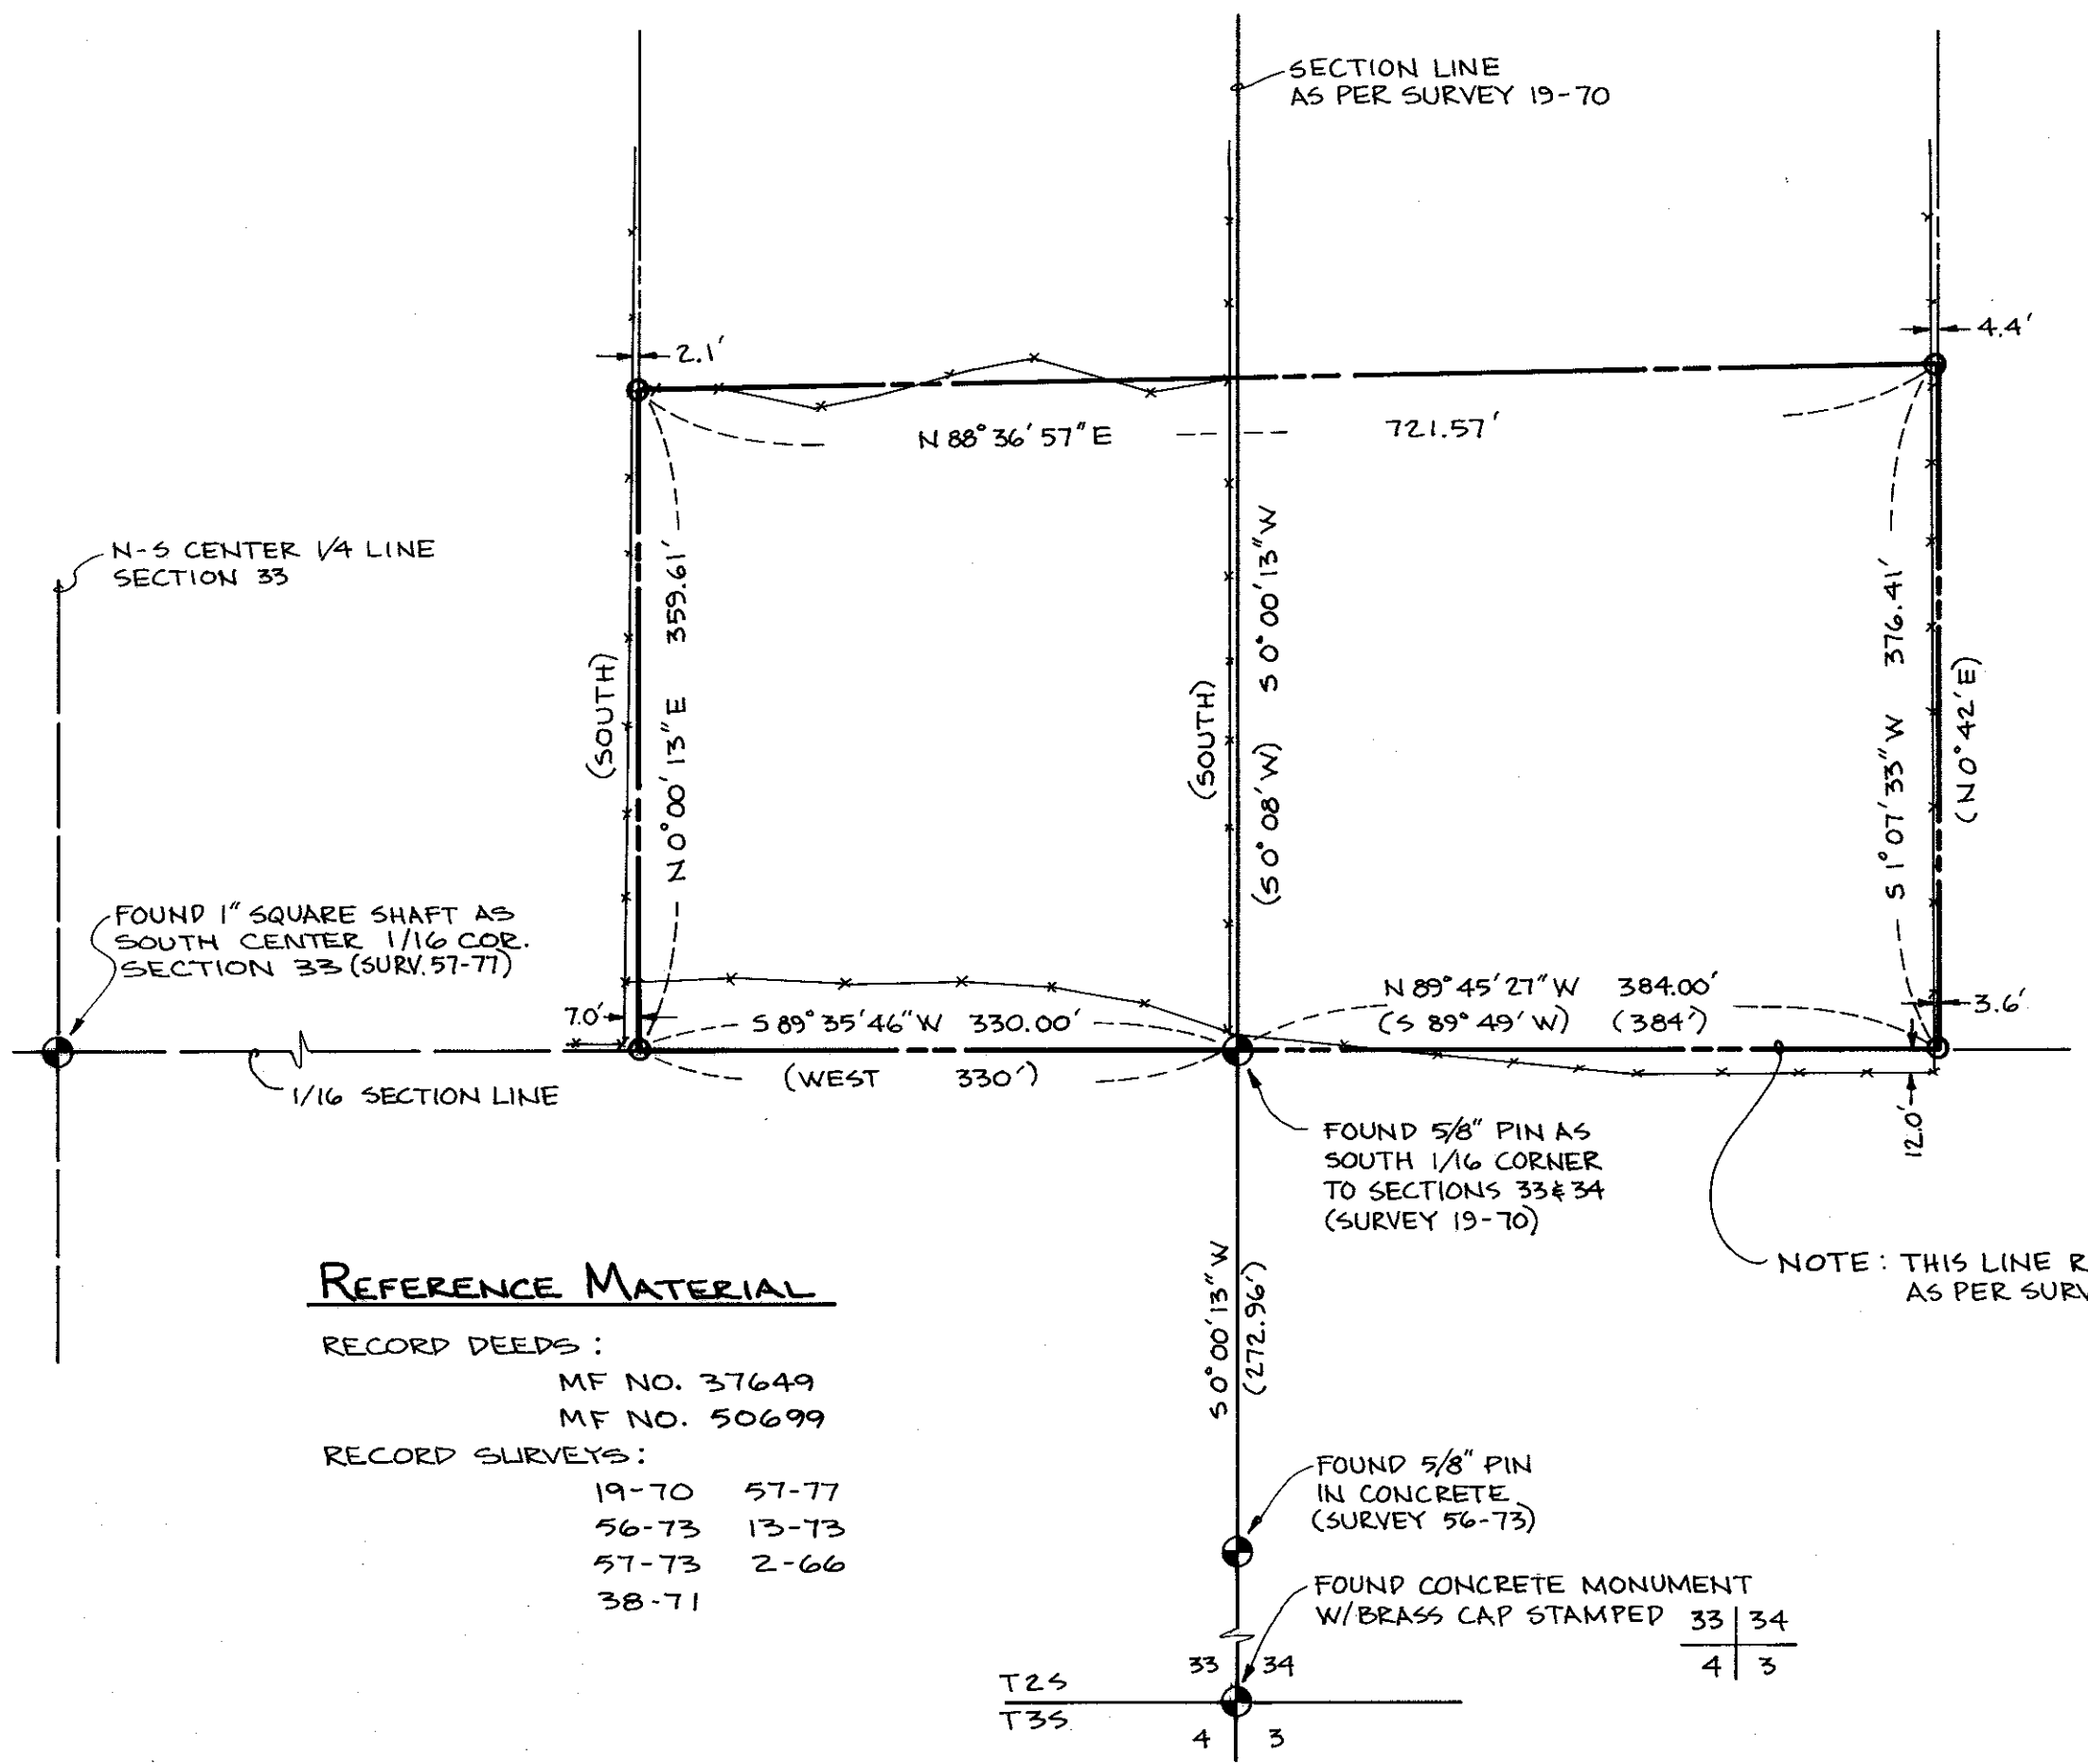

REFERENCE MATERIAL

RECORD DEEDS:
MF NO. 37649
MF NO. 50699

RECORD SURVEYS:
19-70 57-77
56-73 13-73
57-73 2-66
38-71

NOTE: THIS LINE RE-ESTABLISHED AS PER SURVEY 19-70

REGISTERED
PROFESSIONAL
LAND SURVEYOR

Howard L. Perry

OREGON
SEPTEMBER 23, 1977
HOWARD L. PERRY
1294

T2S, R38E, W.M.

MAP OF SURVEY
PARCEL LOCATED IN THE NE 1/4, SE 1/4,
SEC. 33; & NW 1/4, SW 1/4, SEC. 34
FOR: R.D. MAC INC.

SCALE 1" = 100'	<p>anderson perry & associates, inc. engineering • surveying • materials testing LA GRANDE & ENTERPRISE, OREGON</p>	SHEET NO. 1/1
DATE 1979		



49-79