
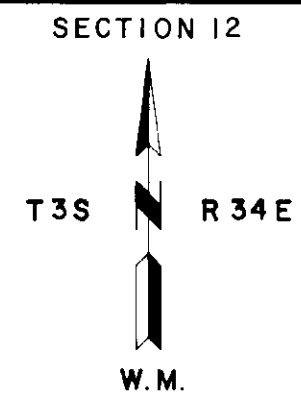


NOTE: CLOSED LOOP TRAVERSE RAN ALONG THE SECTION LINE OF SECTIONS 23 & 24 & 1/4 CORNER SET BY SINGLE PROPORTIONATE MEASUREMENT.

I, BARRY B. BARBOUR, a registered land surveyor in the State of Oregon, hereby certify that this plat and the notes hereon, or attached, are a correct representation of a survey I performed during September - November, 1980, for the U.S. Forest Service in accordance with the Statutes of the State of Oregon and with the articles of the contract.

Barry B. Barbour
Barry B. Barbour
Registered Land Surveyor
Oregon License 1051

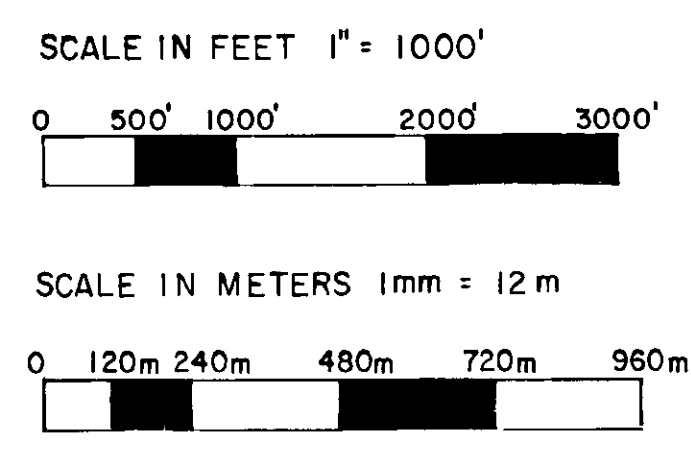

BASIS OF BEARING

SOLAR OBSERVATIONS
SEPTEMBER 23, 1980
NOVEMBER 14, 1980

MEAN MAGNETIC DECLINATION
N 20° 00' E

SURVEY HISTORY

T3S, R34E, W.M., WAS SURVEYED BY RUFUS M. MOORE, UNDER G.L.O. CONTRACT NUMBER 451, DURING NOVEMBER, 1882. NO RECORD SURVEYS WERE FILED WITH THE UNION COUNTY SURVEYOR & NO EVIDENCE OF RECENT SURVEYS WERE FOUND IN THE FIELD FOR SECTION 12, T3S, R34E, W.M.

LEGEND

- FOUND CORNER OF RECORD (BRASS CAP)
- FOUND ORIGINAL CORNER EVIDENCE & SET MONUMENT AS DESCRIBED.
- ⊙ SET MONUMENT FROM SURVEY AS DESCRIBED ON U.S.F.S. FORM R6-7100-57
- [] METERS
- () RECORD BEARINGS & DISTANCES

REFERENCE MATERIAL

ORIGINAL G.L.O. PLAT & NOTES.
FIELD BOOKS 1-7.

NOTES

SECTION CORNERS E-25 & V-21 HAD BRASS CAP MONUMENTS & WERE BROUGHT UP TO U.S.F.S. STANDARDS.

FORM R6-7100-57 FILED AT UNION COUNTY SURVEYORS FOR STANDARD INDEX FILE NUMBERS IN T3S, R34E, W.M. - C-21, E-17, E-19, E-21, E-23, E-24, F-23, F-24, G-21, G-23, G-24, G-25, H-23, H-24, J-21, J-23, J-25, N-21, P-21 & R-21.

REGISTERED PROFESSIONAL LAND SURVEYOR
Barry B. Barbour
OCT 17 1975
BARRY B. BARBOUR
1051

CONTRACT NO. 53-04HI-0-8118N

SECTION 12, T3S, R34E, W.M. UNION COUNTY, OREGON		
U.S.F.S. WALLOWA - WHITMAN N.F.		
SCALE 1" = 1000' 1mm = 12m	BARRY B. BARBOUR	SHEET NO 1
DATE JAN., 1981	PROFESSIONAL LAND SURVEYOR	