


SURVEY 27-87

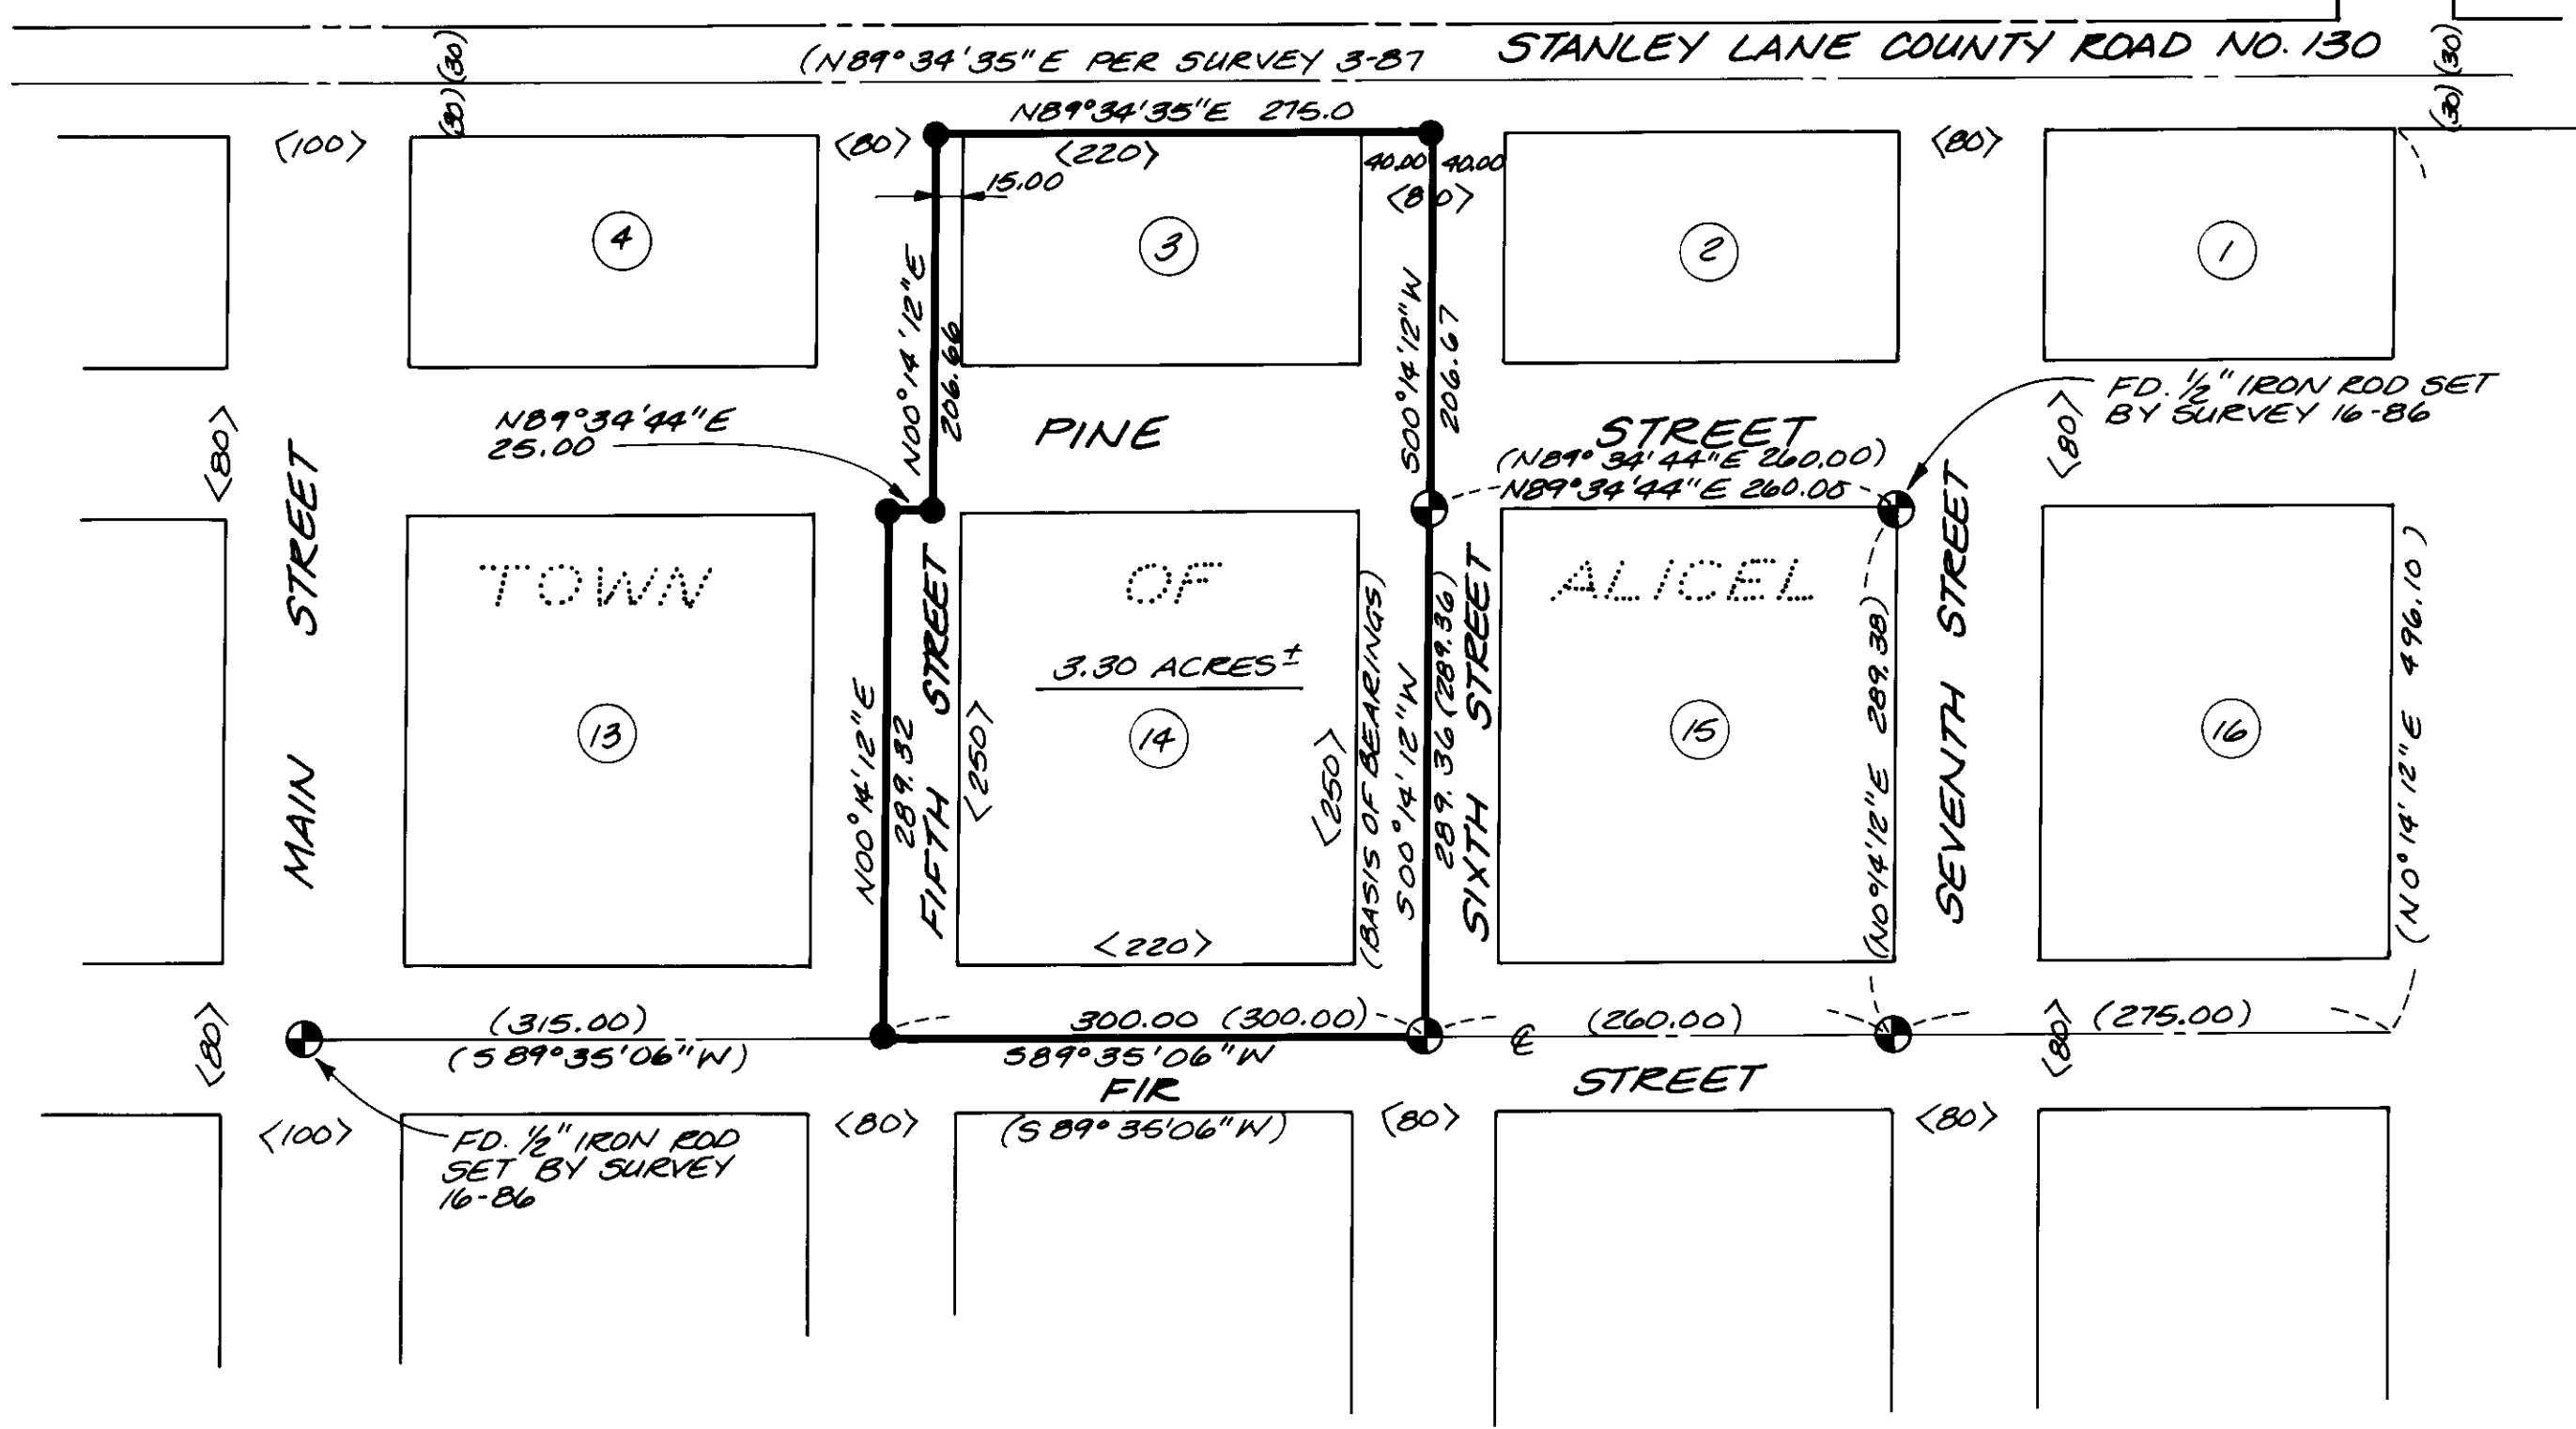

BASIS OF BEARINGS
 S 0° 14' 12" W ALONG THE CENTERLINE OF SIXTH STREET ACCORDING TO UNION COUNTY SURVEY NO. 3-87.

LEGEND

- FOUND 5/8" IRON ROD AS SET BY SURVEY 3-87 UNLESS OTHERWISE NOTED.
- SET 5/8" x 30" IRON ROD (CONCRETE REINFORCING ROD) WITH YELLOW PLASTIC CAP ATTACHED, MARKED "A.P. & A."
- <80> RECORD SUBDIVISION PLAT DIMENSION
- (260) RECORD SURVEY MAP DIMENSION

REFERENCE MATERIAL

UNION COUNTY DEED MICROFILM NO. 123281 (VACATION OF STREETS ADJOINING BLOCKS 3 AND 14)
 PLAT OF THE TOWN OF ALICEL
 UNION COUNTY SURVEYS 16-86 AND 3-87


SURVEY NARRATIVE

THIS SURVEY WAS PERFORMED FOR THE PURPOSE OF MONUMENTING THE BOUNDARIES OF THOSE PORTIONS OF FIR STREET, PINE STREET, FIFTH STREET, AND SIXTH STREET WHICH HAVE ACCRUED TO THE OWNER OF BLOCKS 3 AND 14 IN THE TOWN OF ALICEL BY VIRTUE OF UNION COUNTY COURT ORDER 1986-51, RECORDED JULY 23, 1987 IN DEED MICROFILM NO. 123281, WHICH VACATED PORTIONS OF SAID STREETS.

UNION COUNTY SURVEYS 16-86 AND 3-87 PROVIDE THE ENTIRE BASIS FOR THE SURVEY LOCATIONS ESTABLISHED BY THIS SURVEY. ALL MEASUREMENTS TAKEN AND MONUMENTS FOUND AND SET ARE IN CONFORMANCE WITH SURVEYS 16-86 AND 3-87.

PLEASE NOTE THAT THE VACATED STREETS SHOWN HEREON AS ADJOINING BLOCKS 3 AND 14 REPRESENT ONLY A PORTION OF THE STREETS AND ALLEYS VACATED BY UNION COUNTY COURT ORDER 1986-51.

UNION COUNTY SURVEYOR	
Date Received	9-17-87
Date Filed	9-17-87
By	G. LANGLITZ, DEPUTY
File No.	27-87

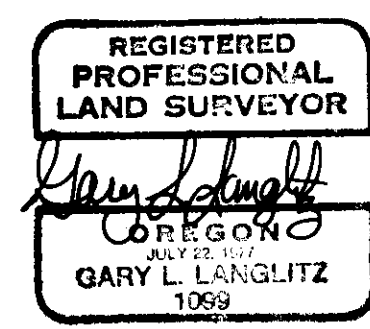

SURVEY OF BLOCKS 3 AND 14, AND VACATED PORTIONS OF FIR STREET, PINE STREET, FIFTH STREET, AND SIXTH STREET, LOCATED IN THE TOWN OF ALICEL, UNION CO., OREGON		
FOR: MARY BENNETT P.O. BOX 225 LINCOLN CITY, OR 97367		
SCALE:	1" = 100'	SHEET NO.
DATE:	JULY, 1987	
JOB NO.	2701-90	

SURVEY 27-87