

REFERENCE MATERIAL

Union County Monumentation Records
 Survey Number 86-77
 Survey Number 53-84
 Survey Number 017-2005
 Survey Number 042-2017

DEED REFERENCES

Microfilm Document Number 20073984
 Microfilm Document Number 20134270
 Microfilm Document Number 20151568


LEGEND

- Found 1 1/2" iron pipe with 2" brass cap marked as per Union County monumentation records, set by Survey Number 86-77
- ⊙ Found 2 1/2" aluminum pipe with 2 1/2" aluminum cap marked as per Union County monumentation records, set by Survey Number 53-84
- ⊙ Found 2 1/2" iron pipe with 2 1/2" aluminum cap marked as per Union County monumentation records, set by Survey Number 042-2017
- Set 5/8"X30" iron pin with plastic yellow cap marked BGB SURVEY MARKER
- [] Record measurement as per Forest Road Easement recorded as Union County Microfilm number 20073984
- Fence post on line
- x— Exiting fence
- Centerline
- .-.- Easement line

BASIS OF BEARING

The West line of Section 13, Township 3 North, Range 39 East of the Willamette Meridian being North 0°15'26" East, as per Survey Number 017-2005

SCALE: 1" = 300'

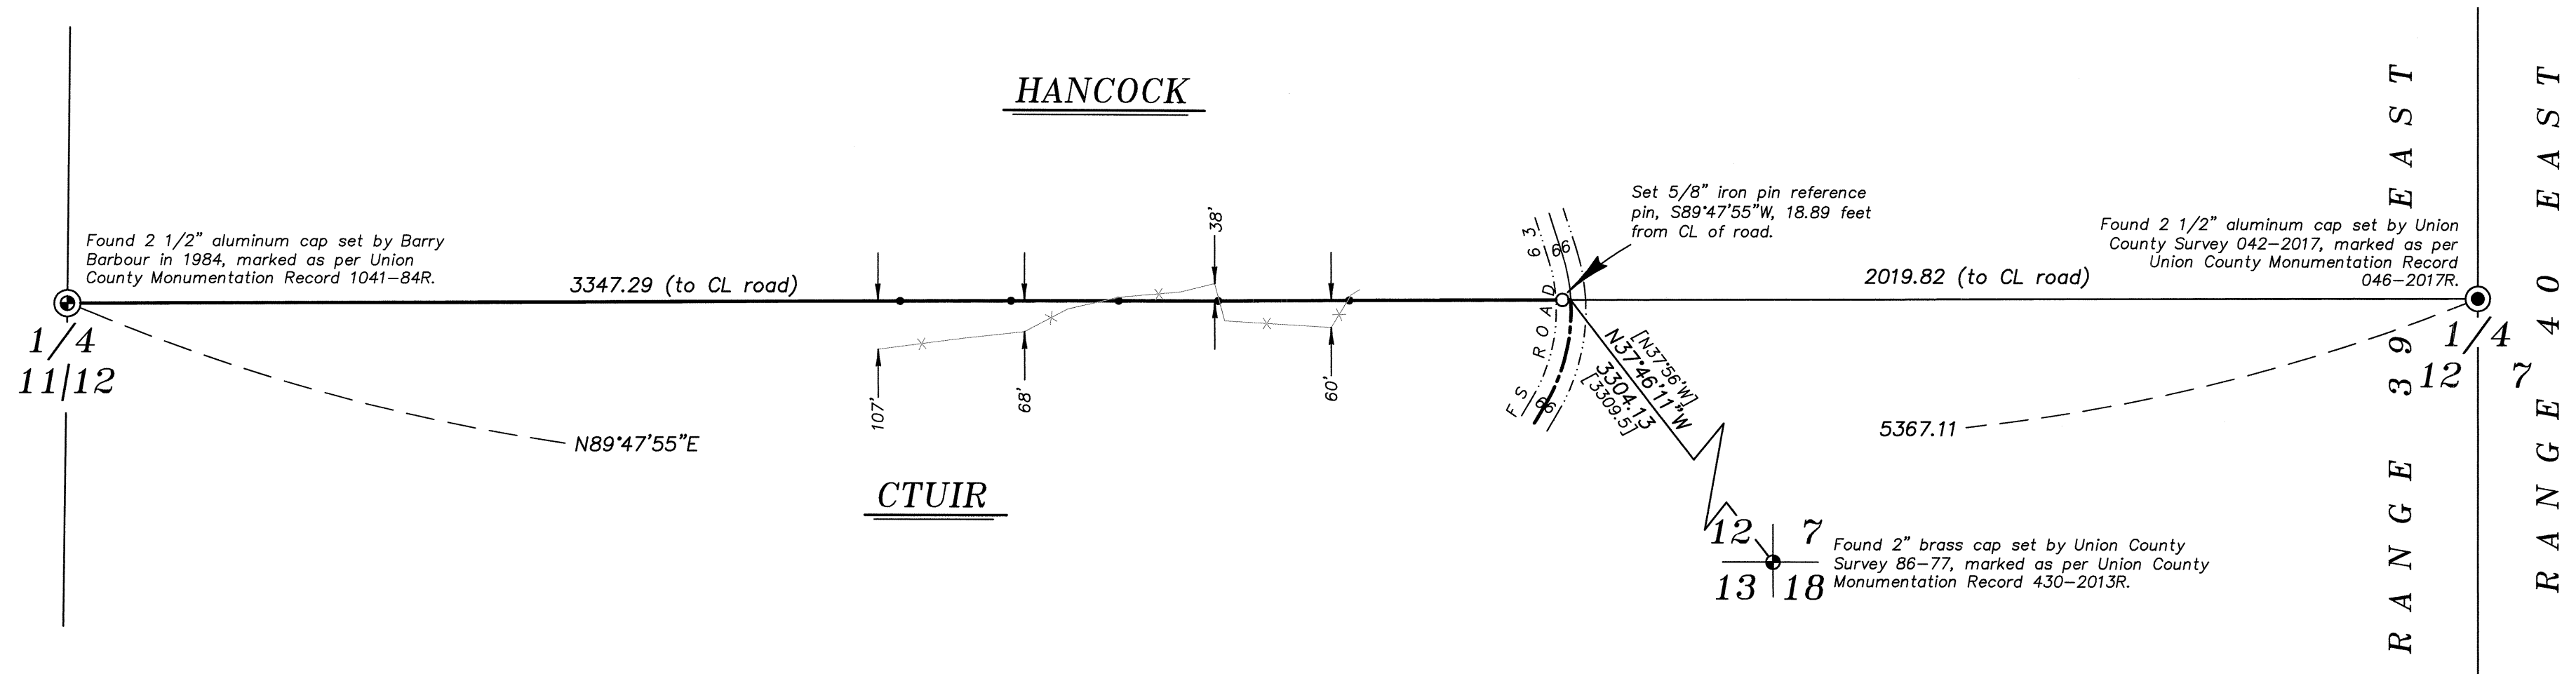

NARRATIVE

This survey was done at the request of Patrick Marolla, on behalf of Hancock Forest Management, land manager of the land within. Mr. Marolla wanted the corner set as well as a portion of the line posted, as shown hereon, prior to a timber sale. I recover the monuments as shown. Forest Service Road 63 is placed as constructed on the ground. I find no unusual conditions with this survey.

REGISTERED
 PROFESSIONAL
 LAND SURVEYOR

OREGON
 JUNE 2, 2010
 JEFFREY S. HSU
 83571

Renewal Date: June 30, 2021

UNION COUNTY
 SURVEYOR
 Date Received 8/20/19
 Date Filed 8/20/19
 By K. A. T.
 File No. 024-2019

BAGETT, GRIFFITH & BLACKMAN
 2006 Adams Avenue, LaGrande, Oregon
 Map of Survey
 Situate in Section 12, Township 3 North, Range 39 East of the Willamette Meridian
 UNION COUNTY, OREGON
 SURVEYED FOR Hancock Forest Management
 SURVEYED BY J. S. H.
 Scale: 1" = 300' Drawn by: K. A. T. Aug. 2019

SURVEY NUMBER 024-2019