



County House

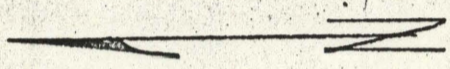

scale 1" = 100'

Block 8 in COGGAN'S Addition to  
La Grande, Oregon

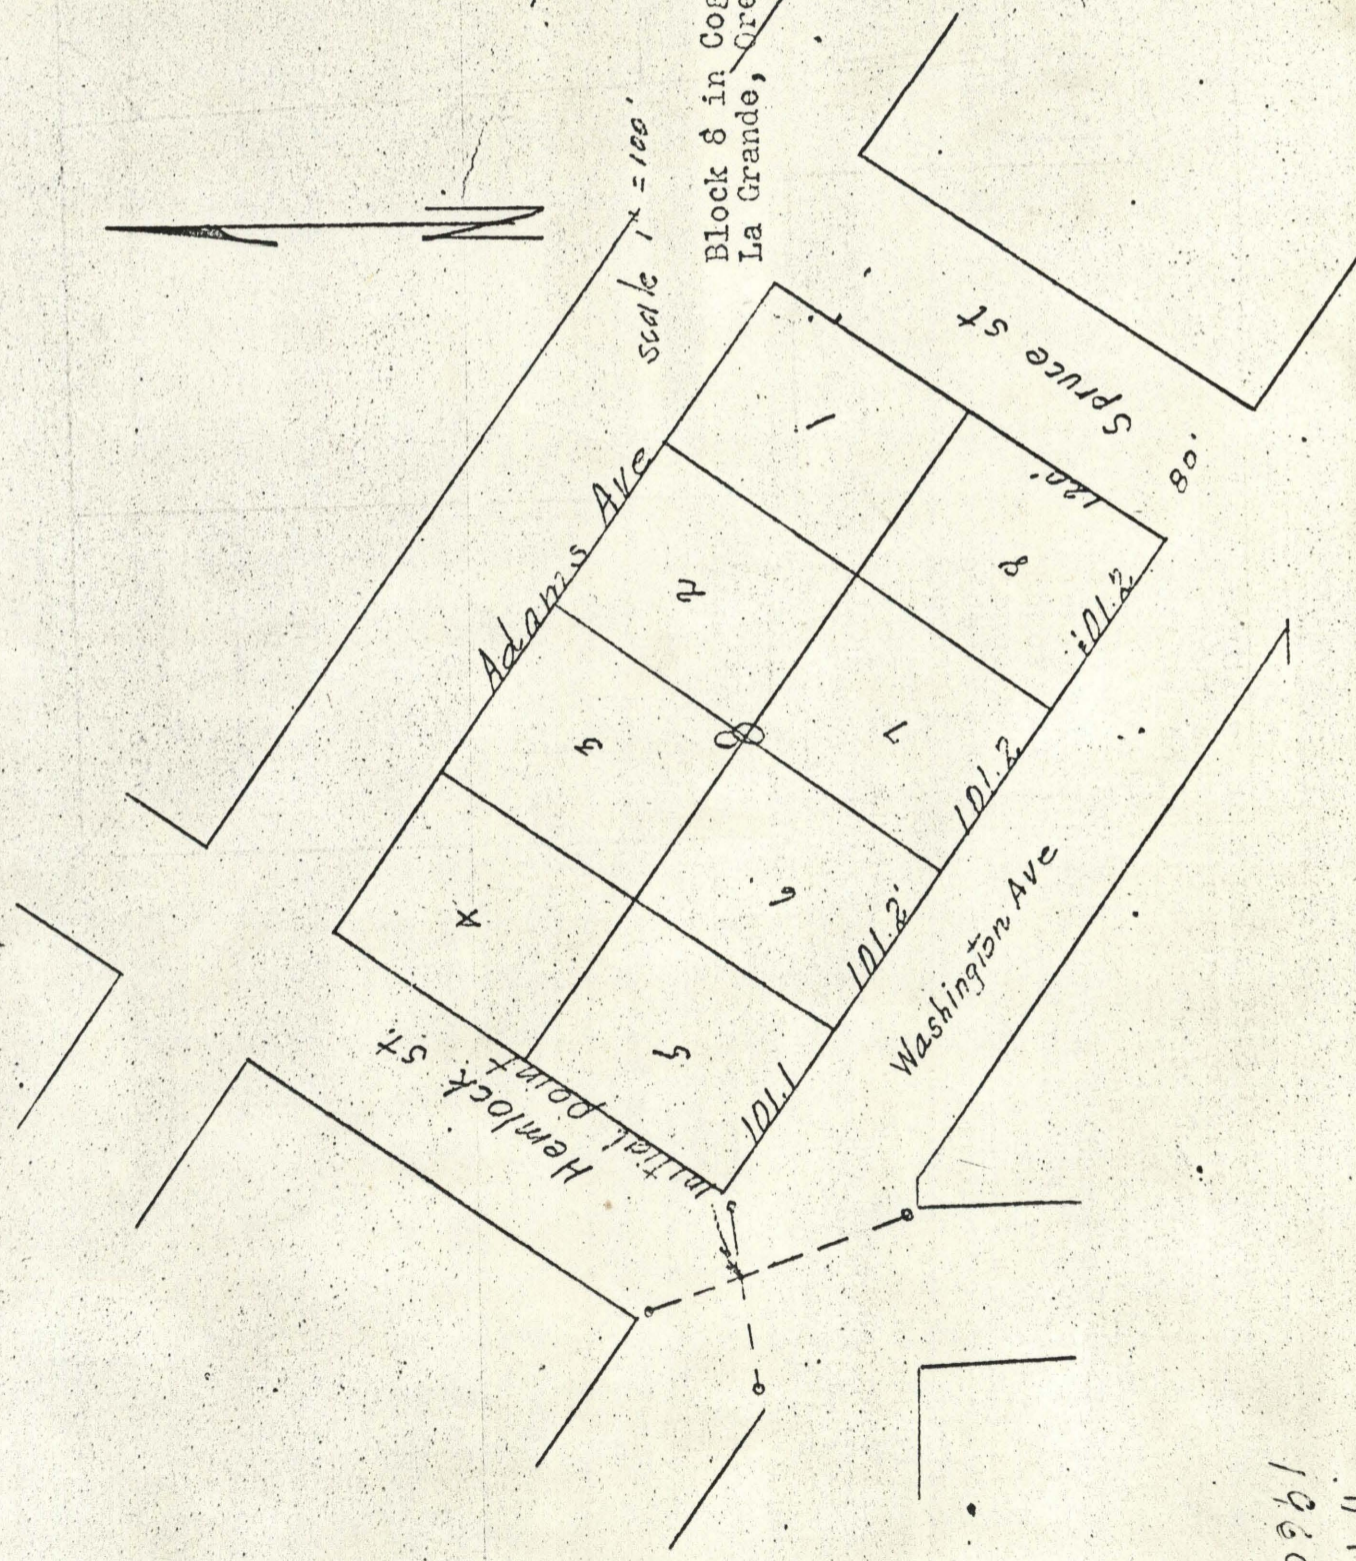

#1  
1960

1-60

1-60