


Property discription

Beginning at a point 35.8 feet Northwesterly from the most southerly corner of block 8 in CoGGans Addition to La Grande, Union County, Oregon, on the Southwest side line of lot 8 in said block; running thence at right angles to Washington Avenue, in a Northwesterly direction, a distance of 76 feet; thence at right angles Northwesterly 32.95 feet; thence at right angles Northeasterly 36 feet to the side line of the alley; thence northwesterly along the Southwest side line of said alley 27.8 feet; thence at right angles to said alley, in a Southeasterly direction 15.1 feet; thence at right angles Southeasterly 96.91 feet; thence in a straight line Southwesterly 96.91 feet to the Southwest side line of said lot 8, at a point 39.4 feet Northwesterly from the point of beginning; thence Southeasterly along the side line of said lot 8 a distance of 39.4 feet to the point of beginning.

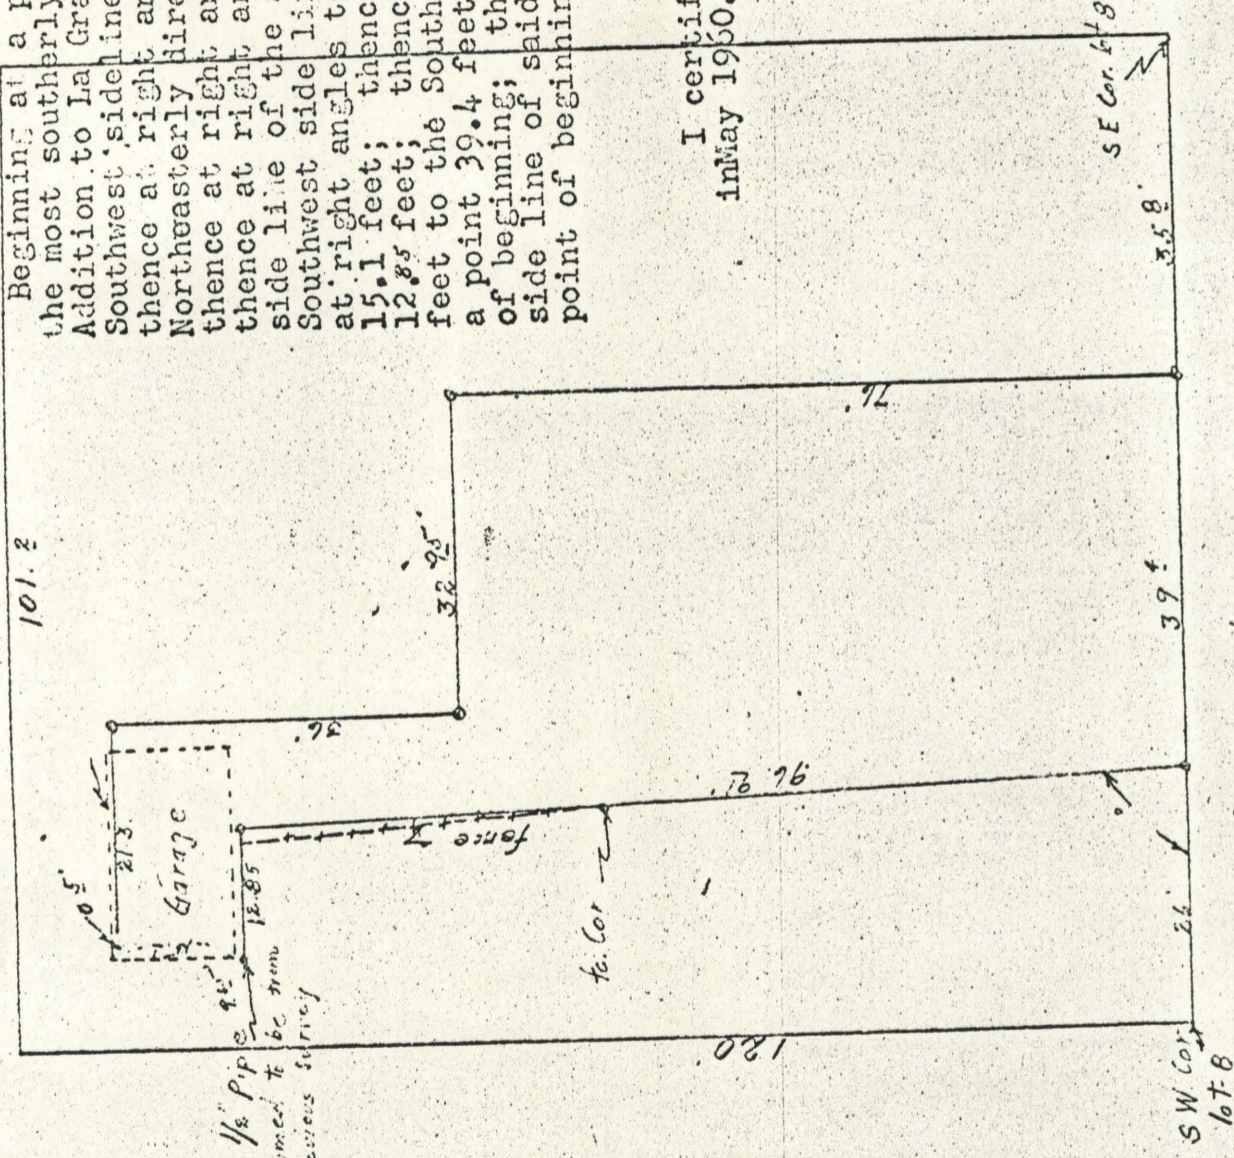

I certify this survey was completed by me
in May 1960.

Scale 1" = 20'