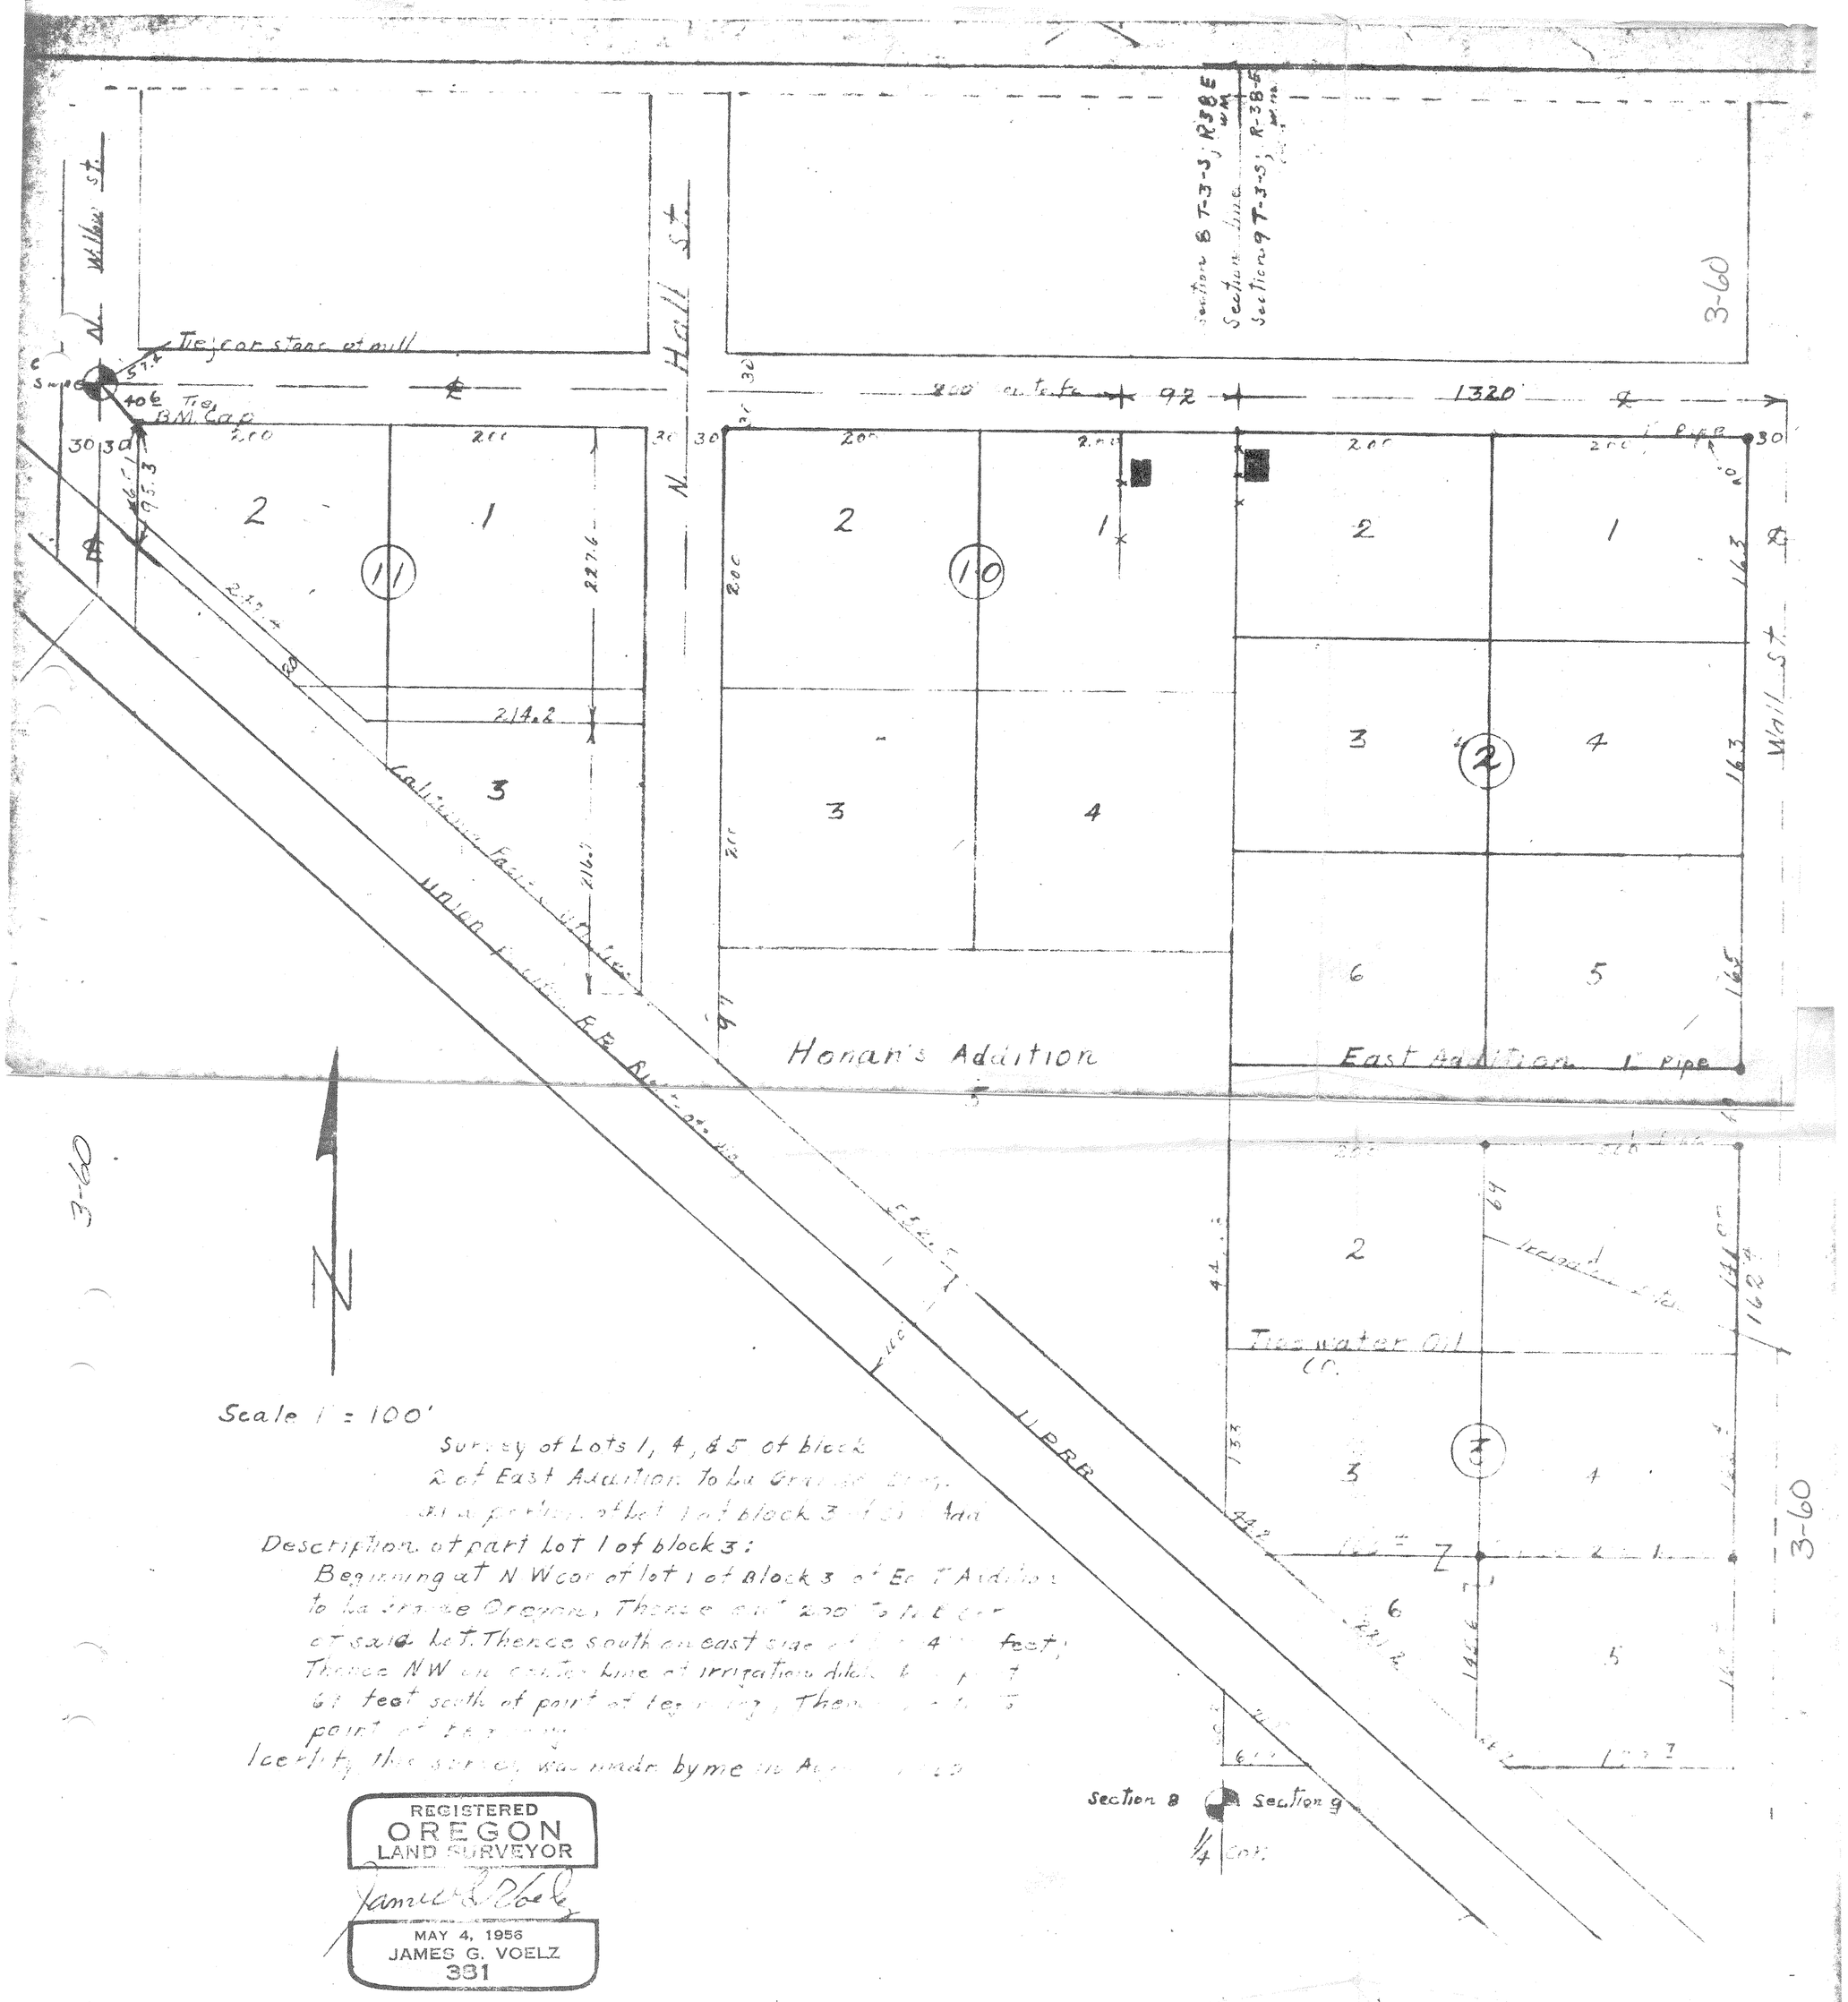

Scale 1" = 100'

Survey of Lots 1, 4, & 5 of block 2 of East Addition to La Grande Oregon, and a portion of lot 1 of block 3 of said add.

Description of part Lot 1 of block 3:

Beginning at N W cor of lot 1 of Block 3 of East Addition to La Grande Oregon, Thence east 200' to N E cor of said lot. Thence south on east side of lot 4[illegible] feet; Thence NW on center line of irrigation dike to point 61 feet south of point of beginning, Thence north to point of beginning.

I certify the survey was made by me in August 1950

REGISTERED
OREGON
LAND SURVEYOR

James G. Voelz

MAY 4, 1956
JAMES G. VOELZ
381