


19-3

3-6

Subdivision of tract of land for John F. and Ruth E. Corriell.  
 Survey completed October 12, 1961.

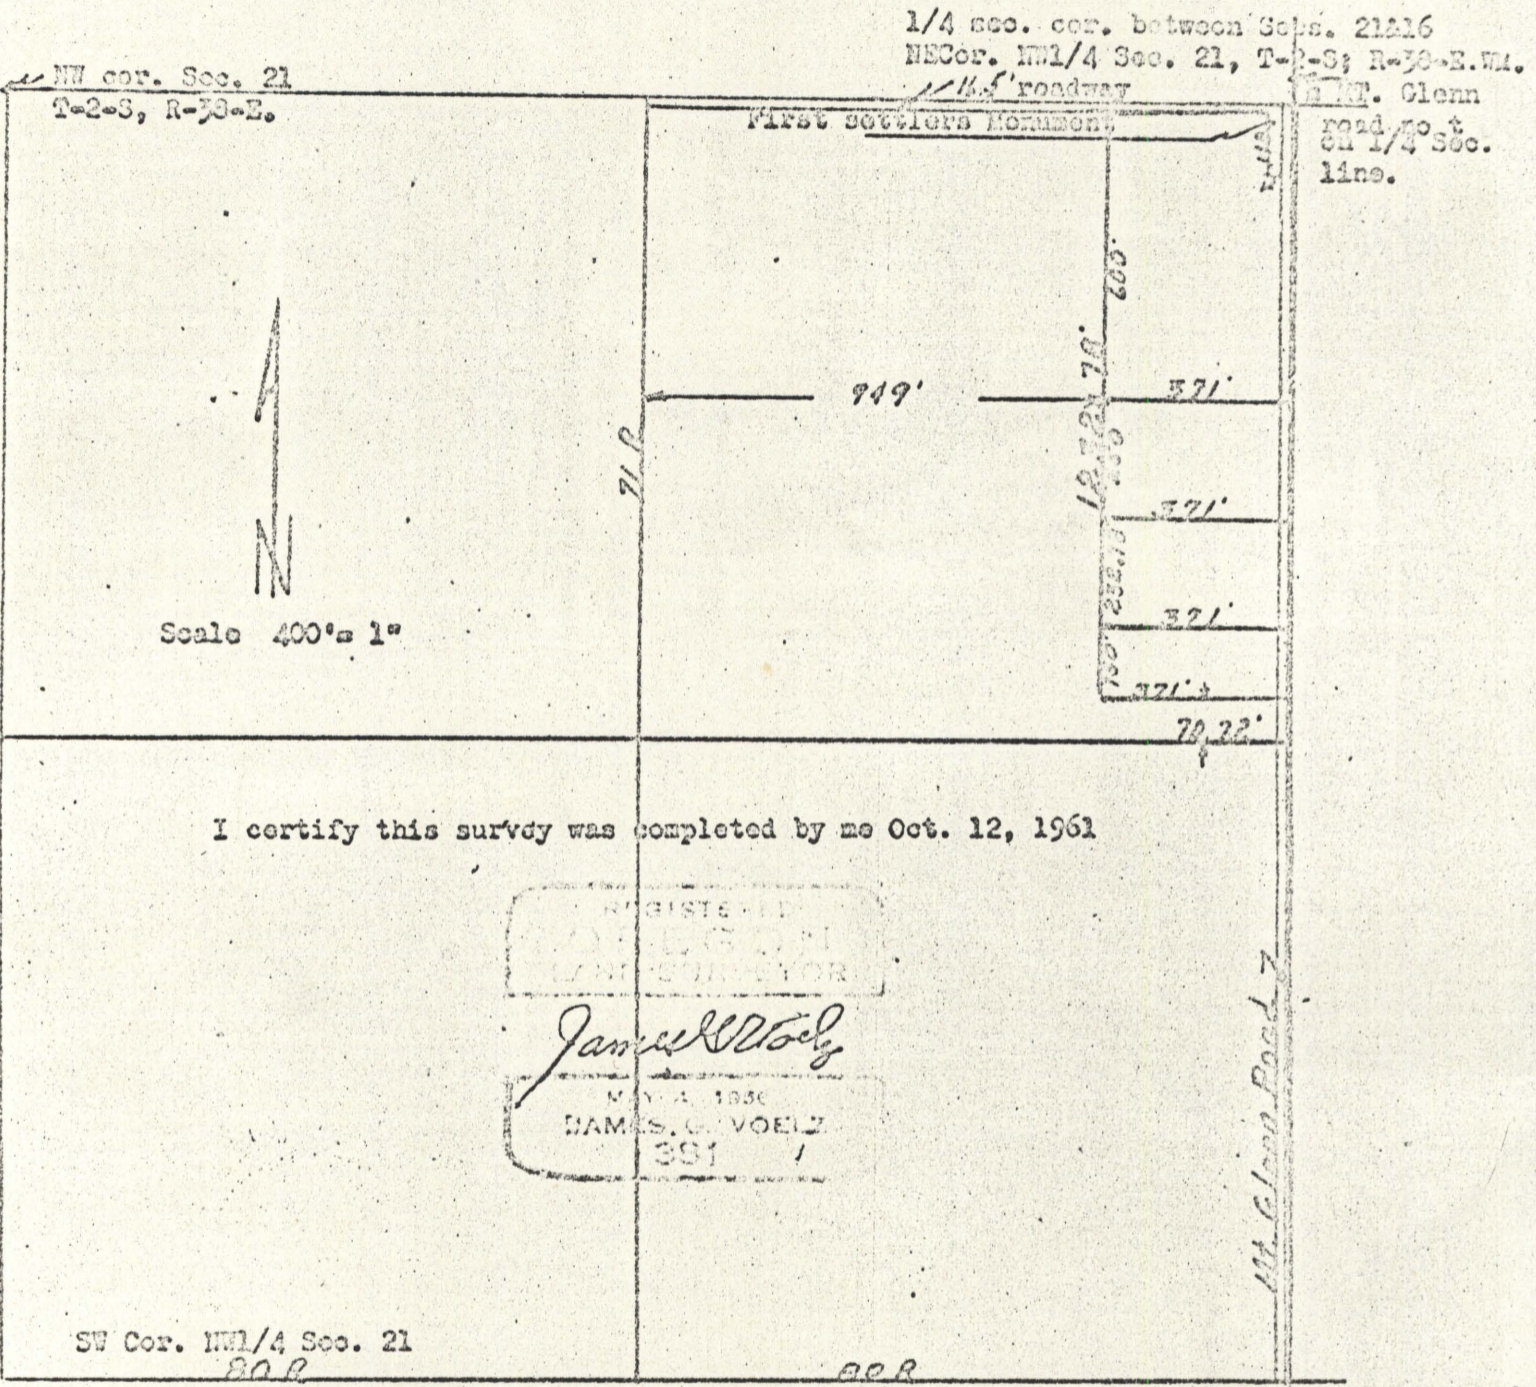

#3-61