


9-61

9-64

9-61




Survey of east one half lot six and south one half of east half of lot five of block six Willam Addition to La Grande Oregon.

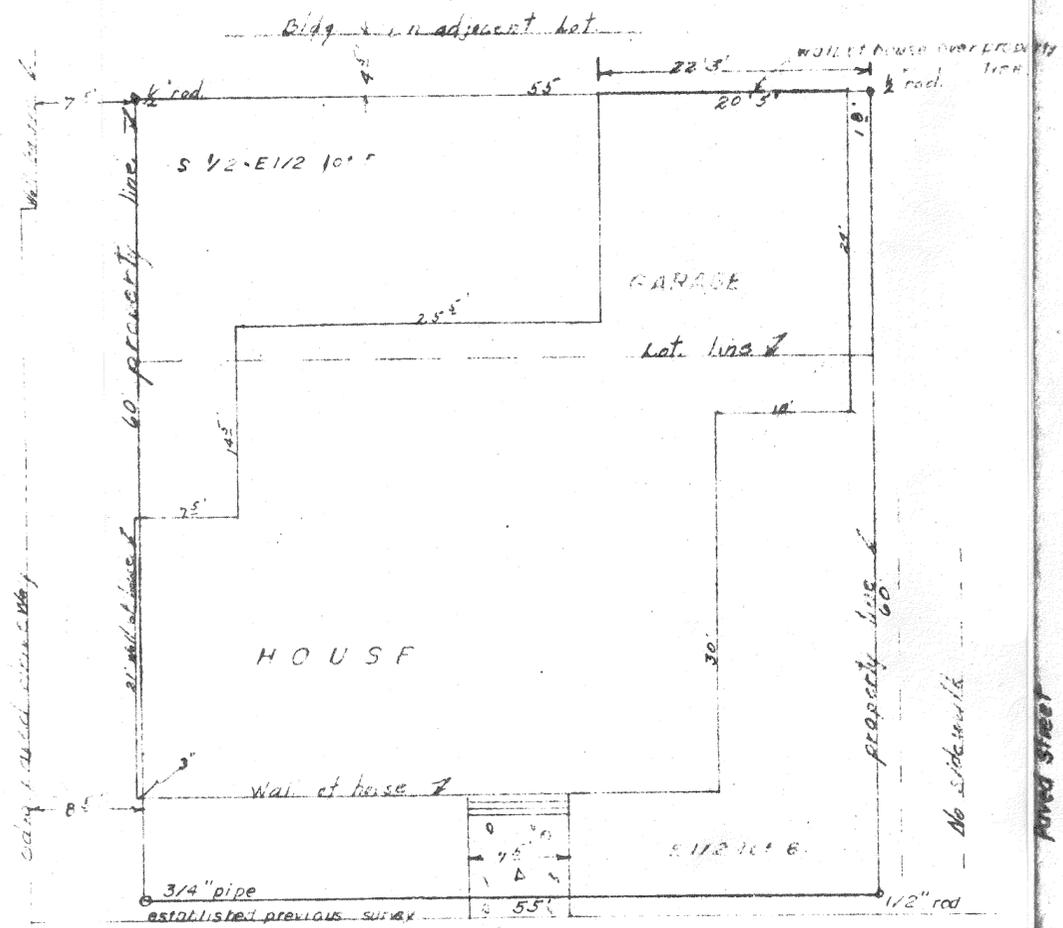

Scale 1" = 10'

I certify this survey was completed by me on April 24, 1961, and corners established in accordance with recorded plat. The house is located on lots as shown and extends beyond limits of lots. The buildings on adjacent lots do not encroach on platted lots.

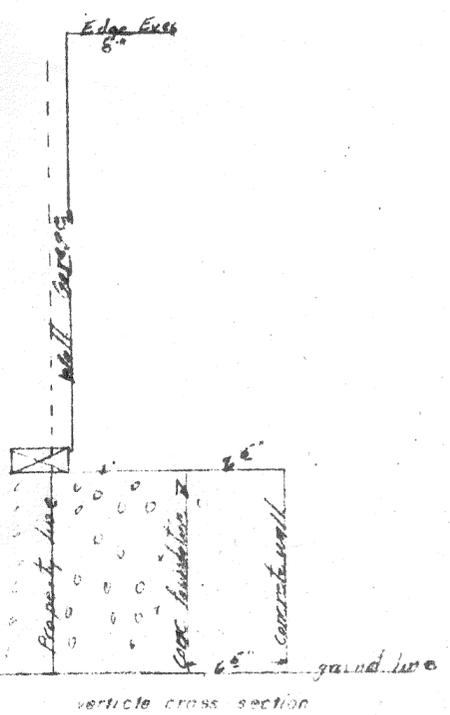

detail of overhang on north side of property

REGISTERED OREGON LAND SURVEYOR

James G. Voelz

MAY 4, 1958 JAMES G. VOELZ 381

(9-61 CONT)

9-61 (CONT)

9-61

9-61