


19-11

19-11

Survey for H. G. Carter
1407 North Hall Street.
La Grande, Oregon
Property to Jack T. Mahan

Survey completed on
June 26, 1961

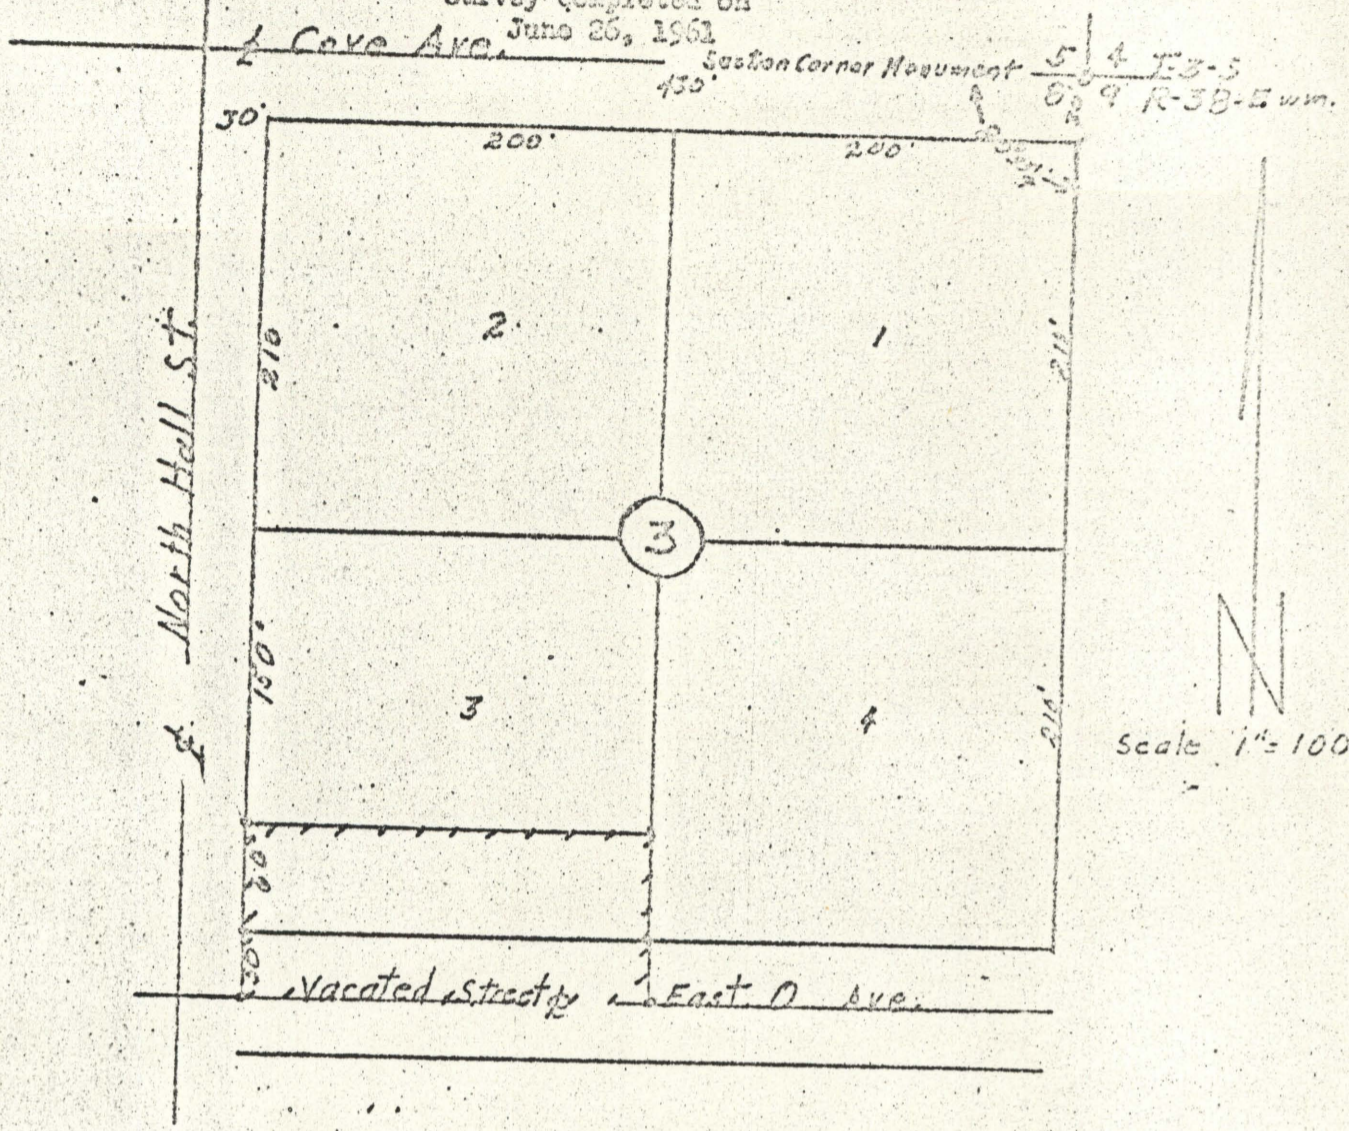

Subdivision of Lot 3 of Block 3 of Henan's Addition to La Grande, Oregon
Description: The South 60 feet of Lot 3 of Block 3 of Henan's Addition to La Grande, Oregon and the North 1/2 of vacated East "O" Ave. adjacent to said lot.

REGISTERED
OREGON
LAND SURVEYOR

James Daily

MAY 4 1961
JAMES G. VOELZ
231

11-1961