29-1

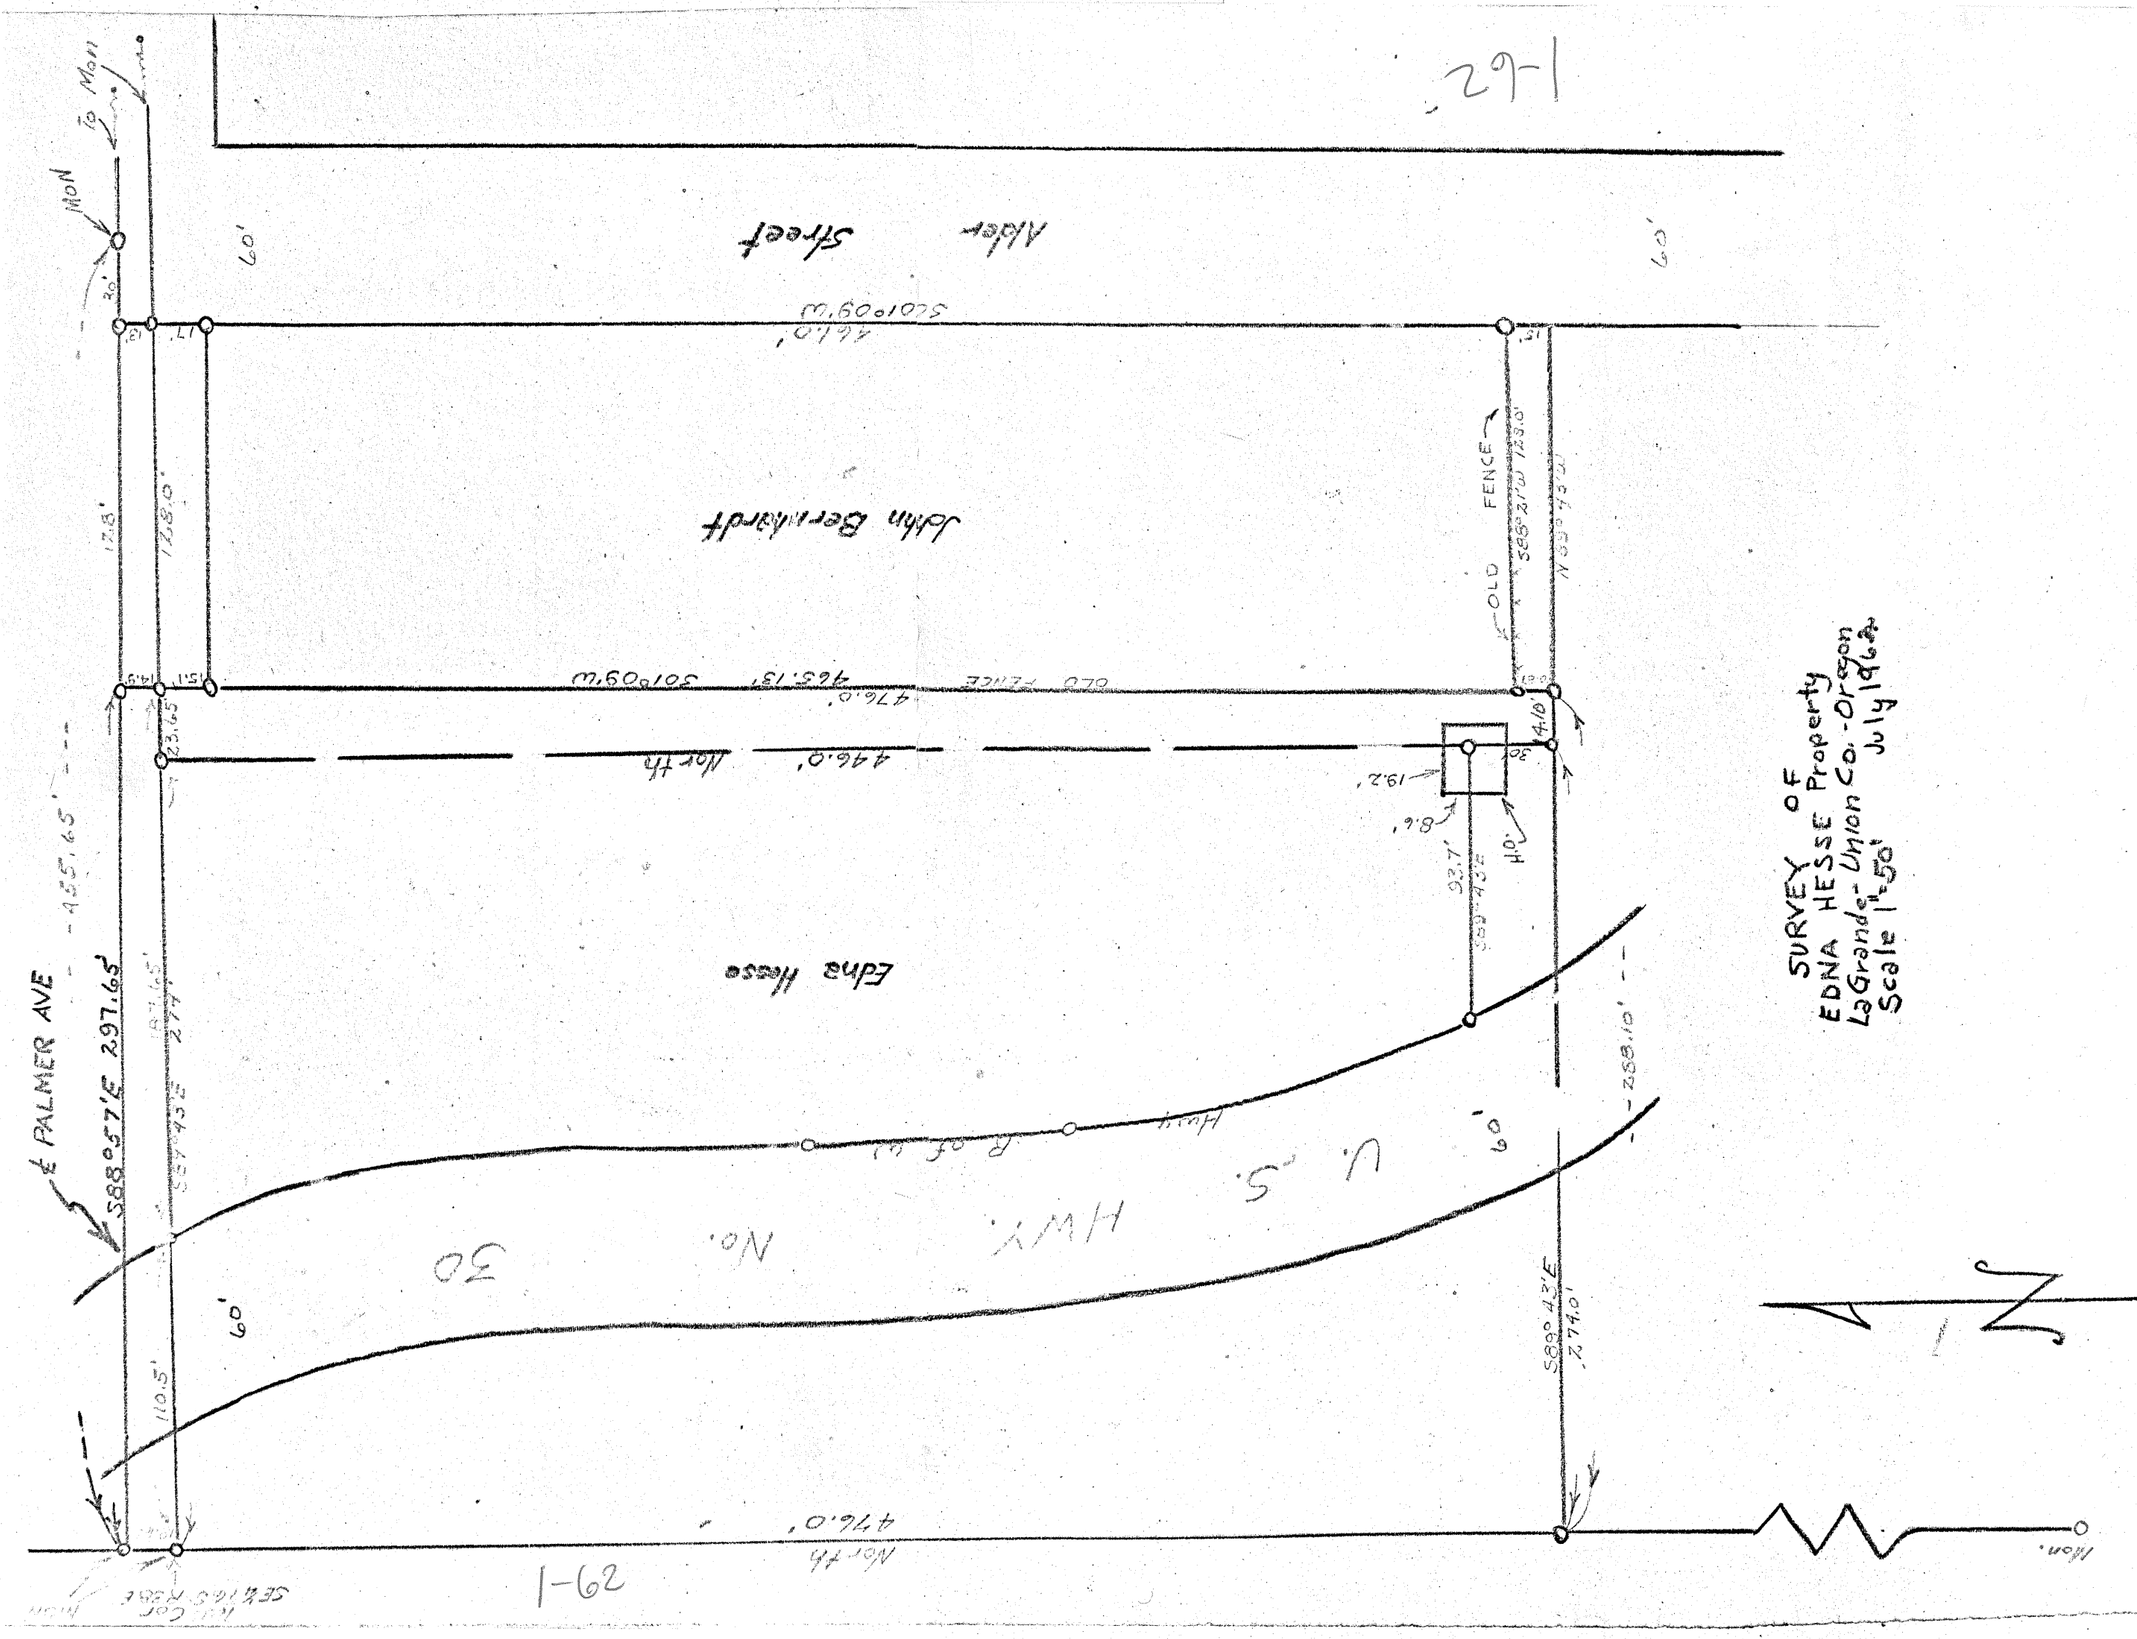
Alder Street
60'
S 0°10'09" W 446.0'
John Bernhardt
OLD FENCE
S 88°57'E 297.65'
Edna Hesse
North
446.0'
476.0'
S 0°10'09" W 463.13'
OLD FENCE
S 88°57'E 297.65'
U.S. HWY. No. 30
60'
110.5'
SURVEY OF
EDNA HESSE Property
La Grande - Union Co. - Oregon
Scale 1" = 50'

29-1