


Survey for Verne Newkirk

Survey of South 39 ft. of lot 10 and all of lot 3 of Block 14 of Arnold's Addition to La Grande, Union County, Oregon

Survey completed March 23, 1962

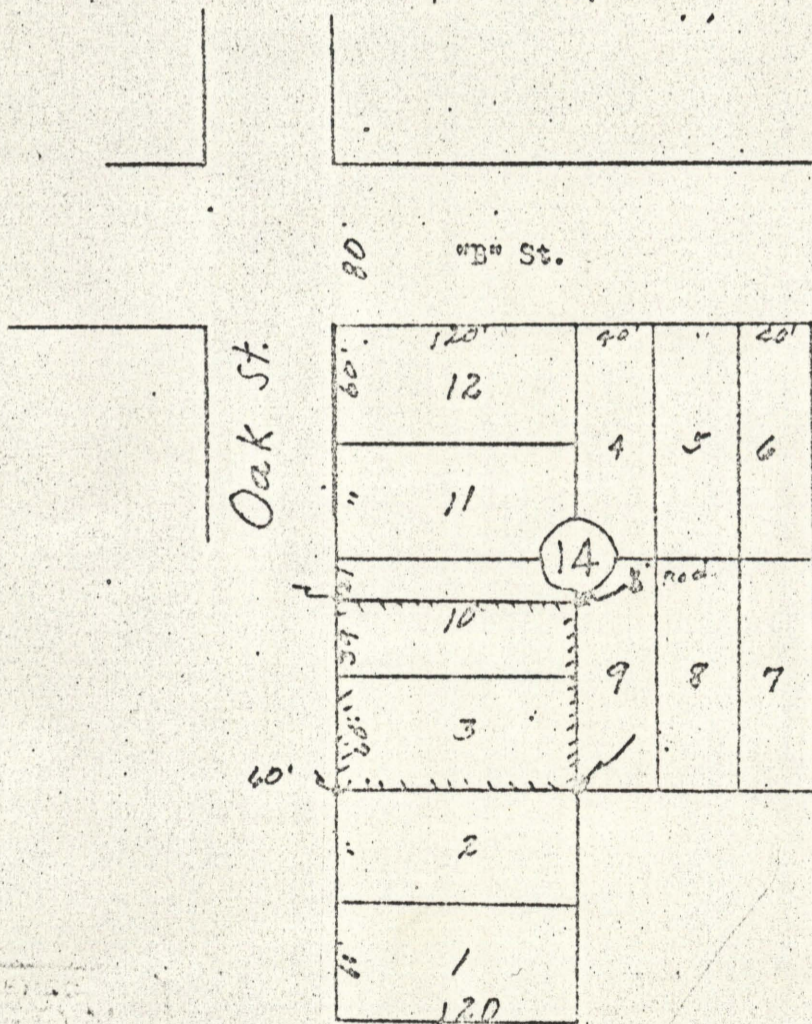

Scale 1" = 100'

REGISTERED  
 CIVIL ENGINEER  
 LICENSE NO. 1000  
*James D. Dady*

2-62

2-1962