29-b

4-62

Survey for La Grande Cemetery District
Odd Fellows Cemetery

Survey completed April 27, 1962

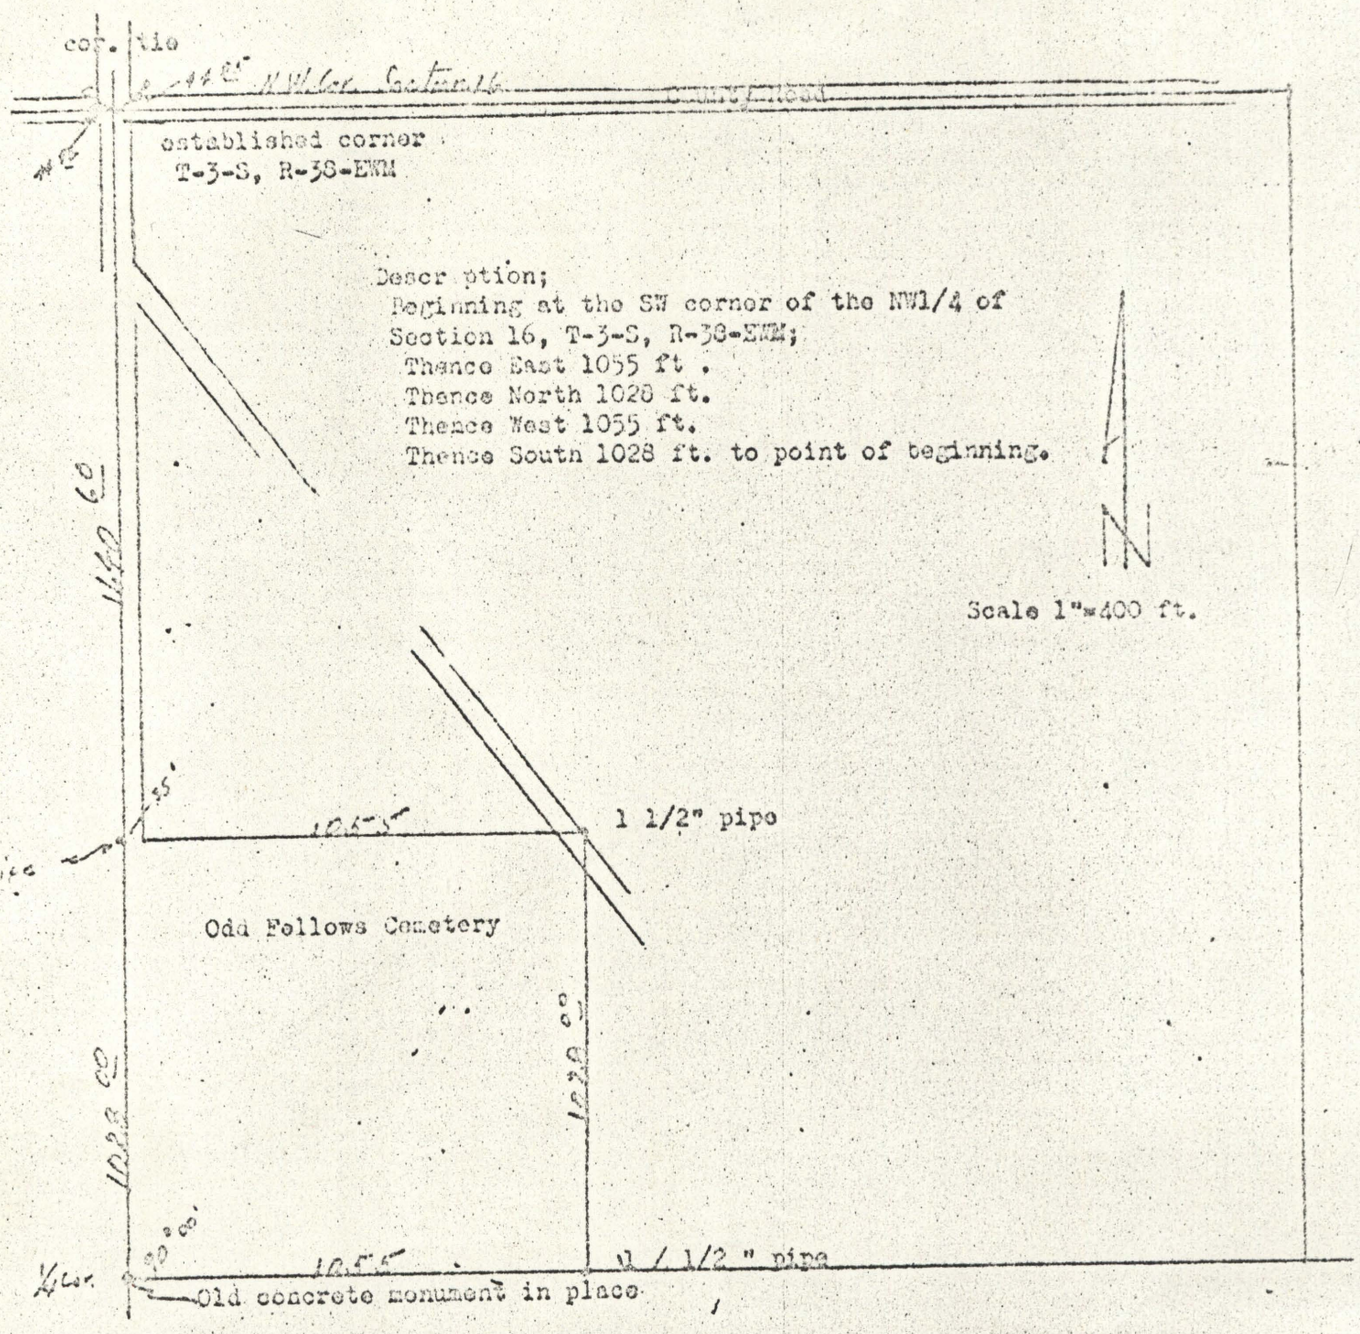

4-1962