
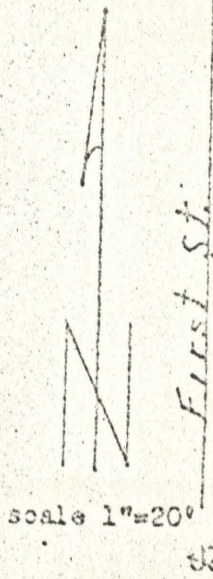


27-5

27-5

Survey for
Theodore R. & Ouida Mae Hunter
701 N. Ave.
La Grande, Oregon

date November 9, 1962

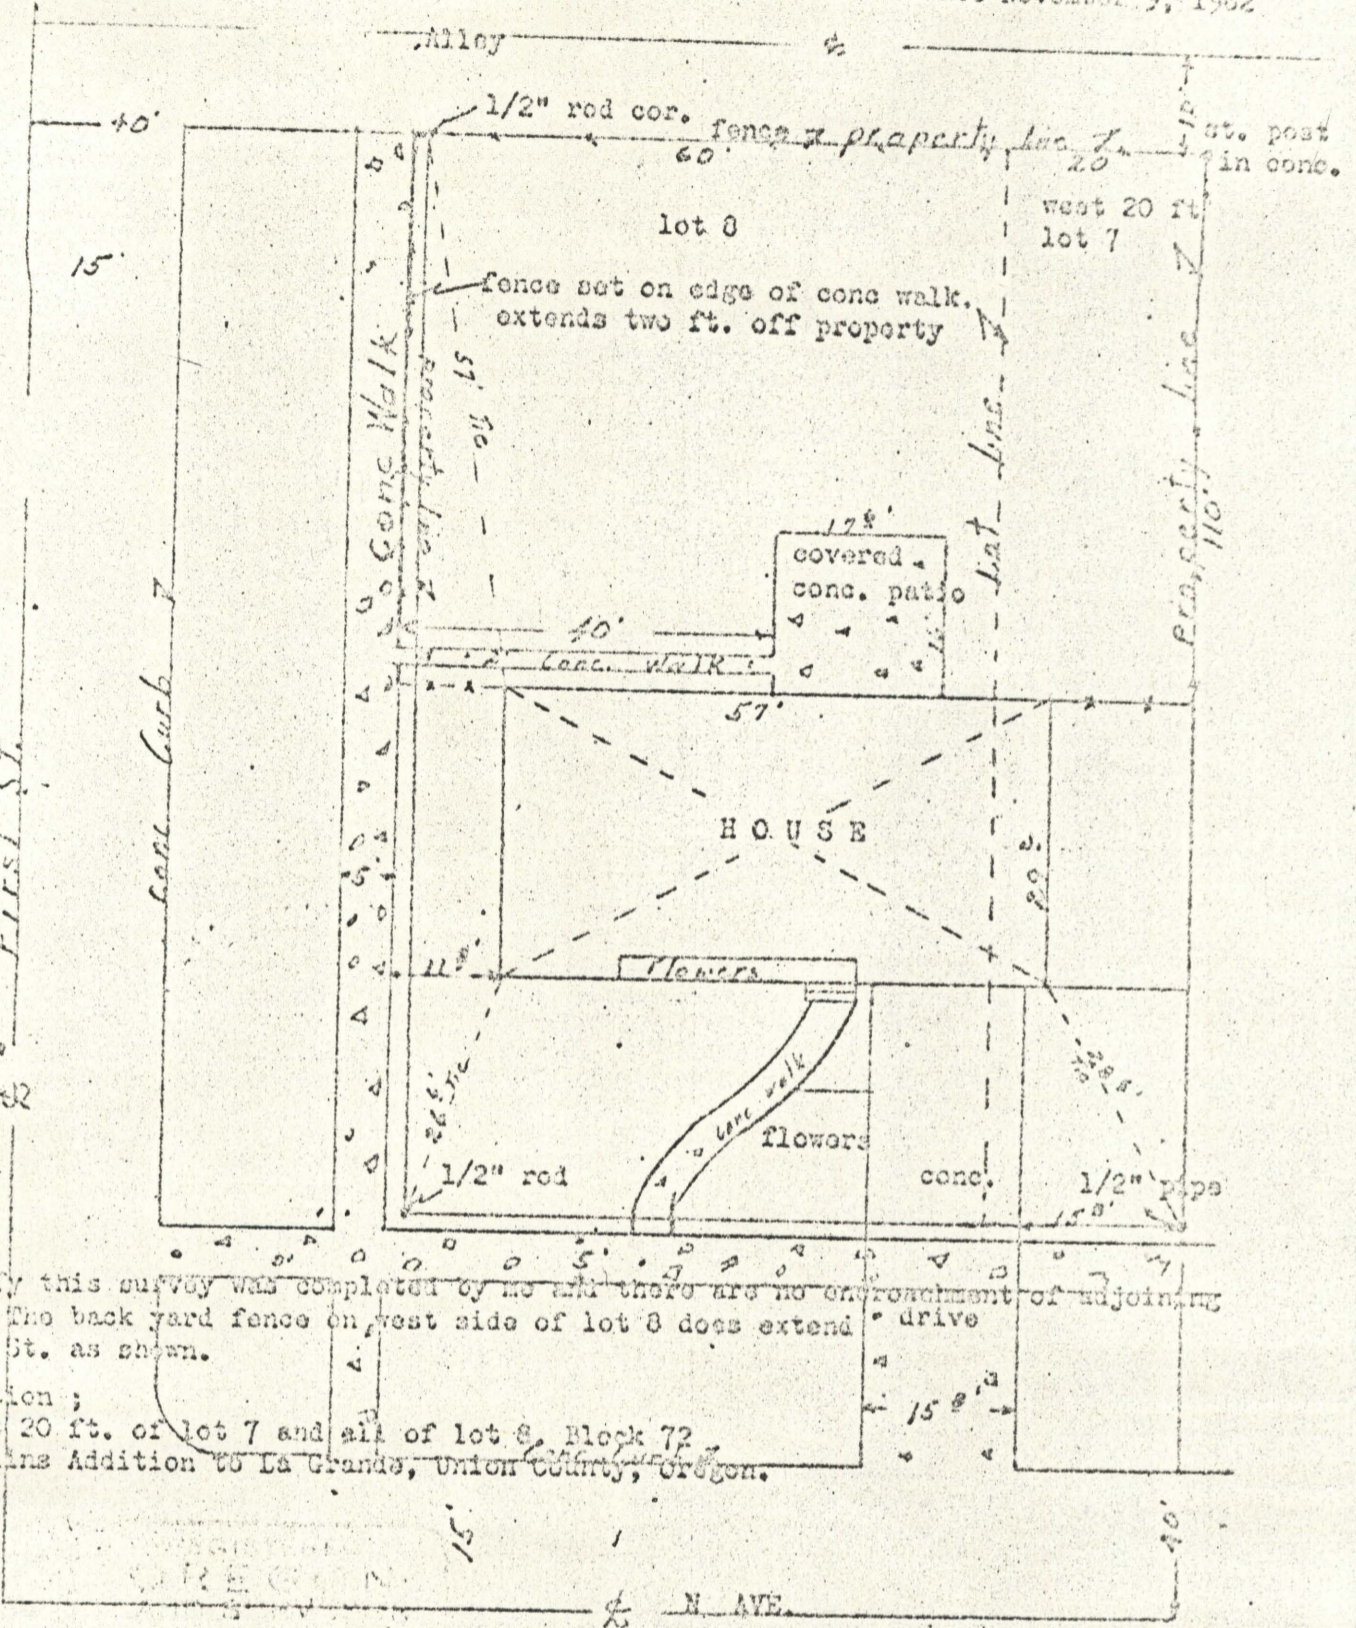


Description;
West 20 ft. of lot 7 and all of lot 8, Block 72
of Chaplins Addition to La Grande, Union County, Oregon.

James R. Kelly
Surveyor

5-1962