

299

299

C. house


Survey for Charles E. Wilson
1715 Washington Avenue
La Grande, Oregon

Survey September 26, 1962

Block 7 of Coggan's Addition to
La Grande, Oregon



Scale 1" = 100'

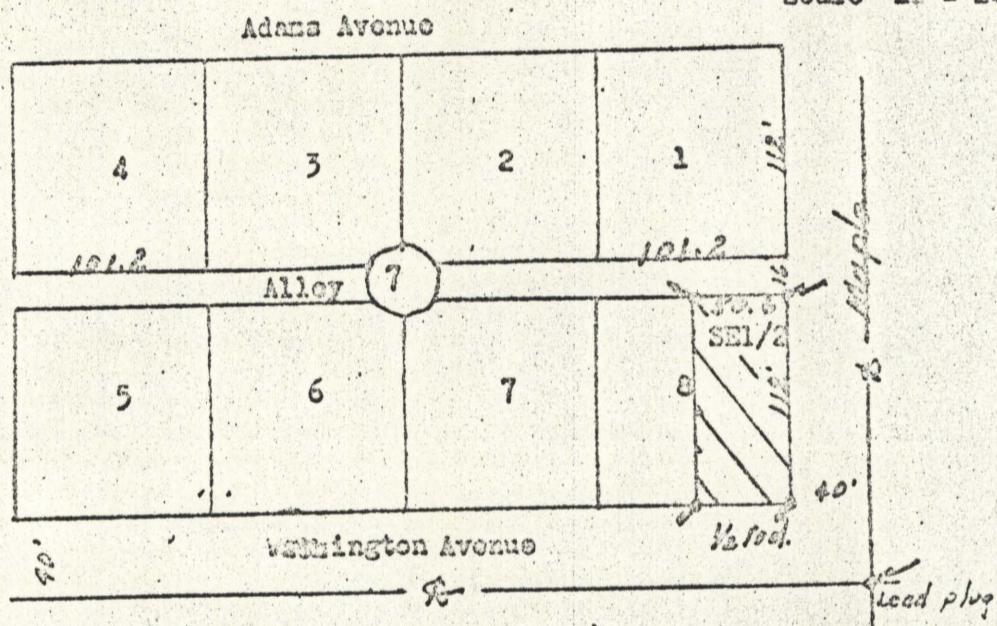

Description;

SE 1/2 of lot 8 of Block 7 of Coggan's Addition to
La Grande, Oregon

6-1962