C Hall

Survey for Ivan Tillery

1201 Cedar St.
La Grande, Oregon

June 1, 1962

Block 12 Chaplins Addition

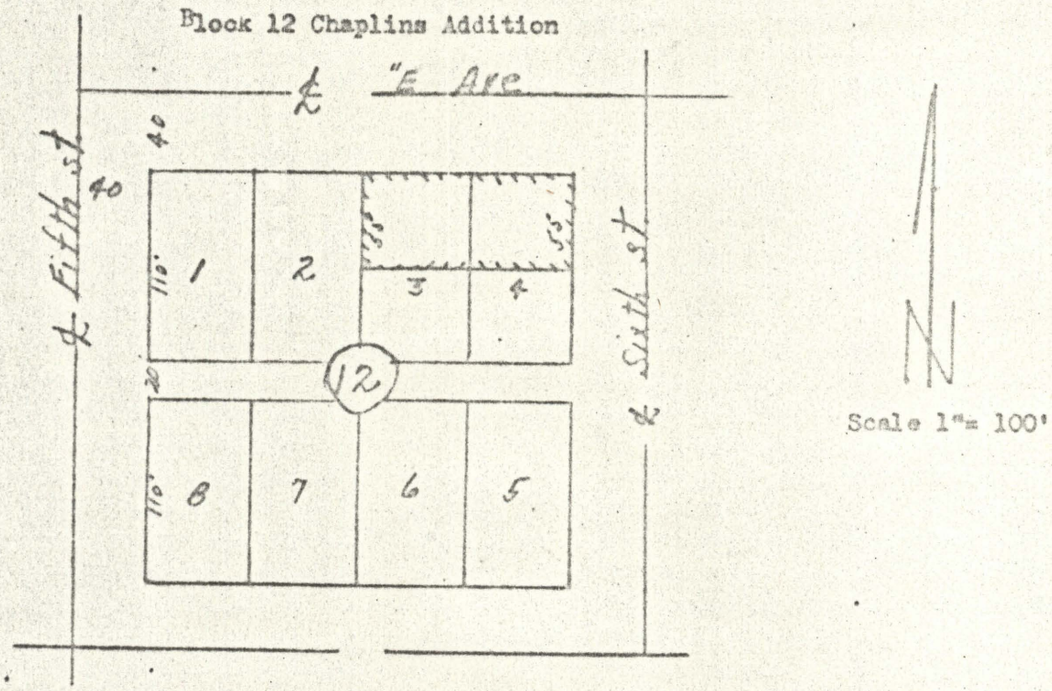


Description;

North one half of Lot s 3 and 4 of Block 12 of Chaplins Addition to La Grande, Oregon.

REGISTERED
OREGON
LAND SURVEYOR
James G. Voelz
MAY 4, 1956
JAMES G. VOELZ
301

9-62

9-62