


United States Post Office Site

C.H.

All of lots 1, 2, and 3 and North one half of lot 4, all in Block 102 of Chaplins Addition to La Grande, Union County, Oregon.
All of lots 15, 16, 17, 18, 19, and 20 of Block 102 of Chaplins Addition to La Grande, Union County, Oregon.

Survey completed August 5, 1962

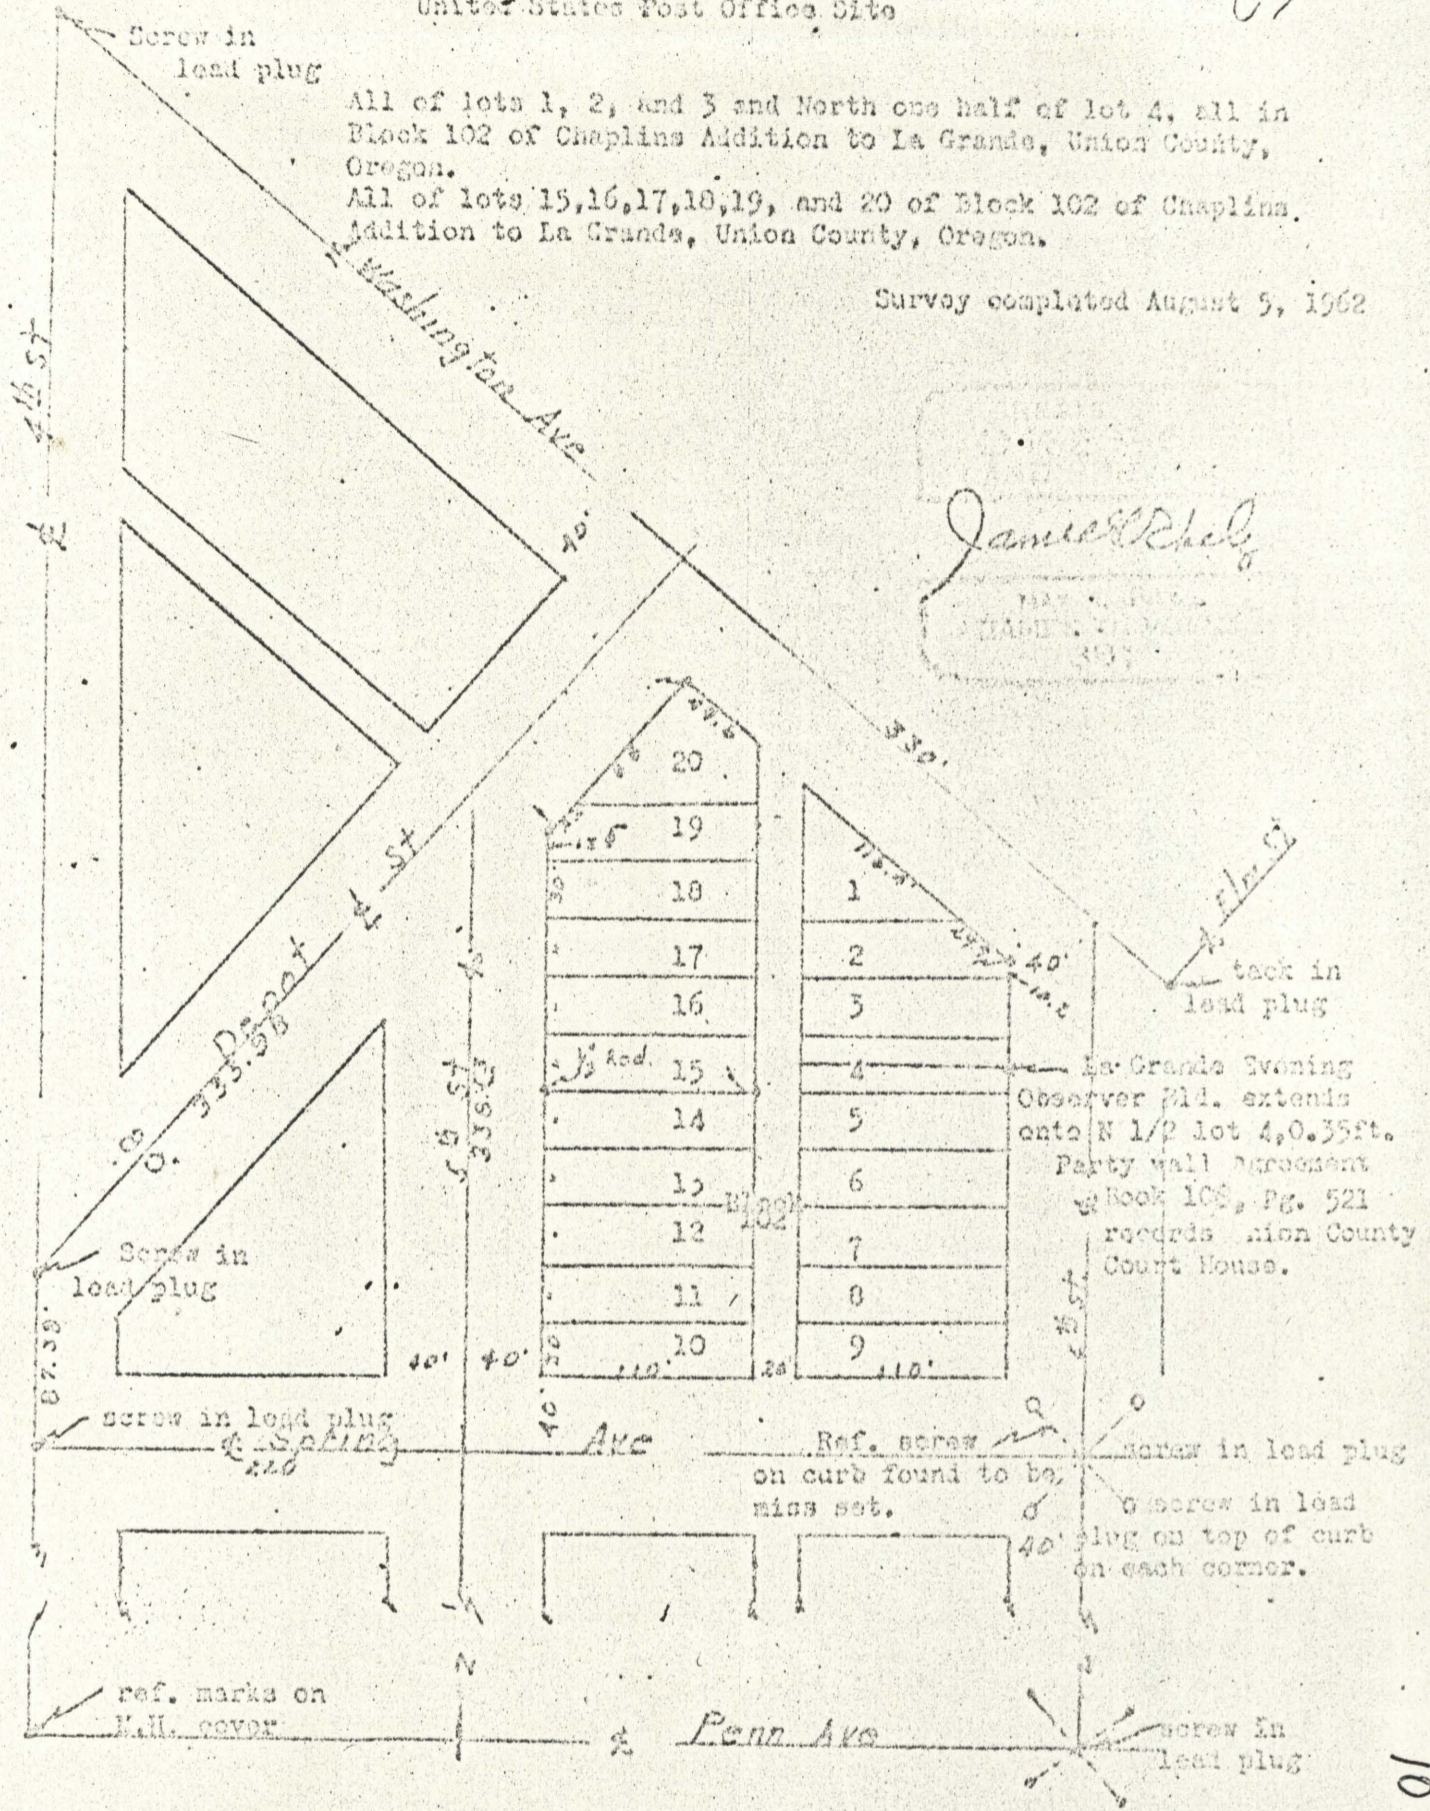

10-1962