


29-11

29-11

C-H.

Survey for James Klein
Lots 4 & 5, Block 2 of
Honan's Addition to La Grande, Oregon
care of S/D

Survey completed March 31, '62

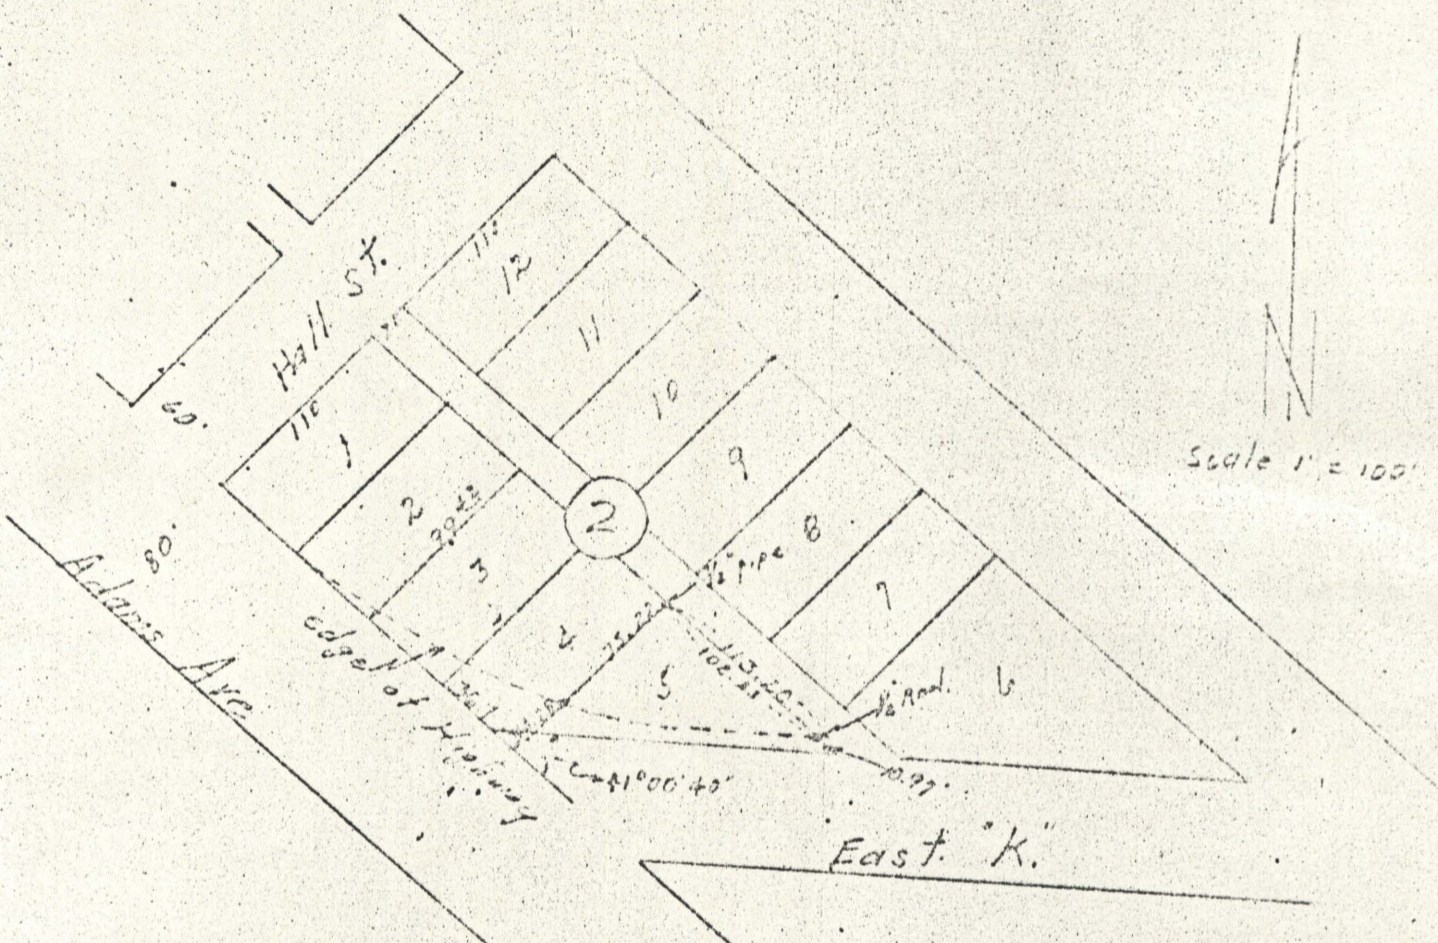

REGISTERED
OREGON
LAND SURVEYOR

James G. Tooley
MAY 4, 1960
JAMES G. TOOLEY
387

11-1962