


14-62

14-62

Survey for Wm. Jeffers
Island City Highway
La Grande, Oregon


July 15, 1962

James W. Kelly

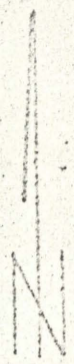

Scale 1" = 100'

Original Town
of
La Grande, Oregon

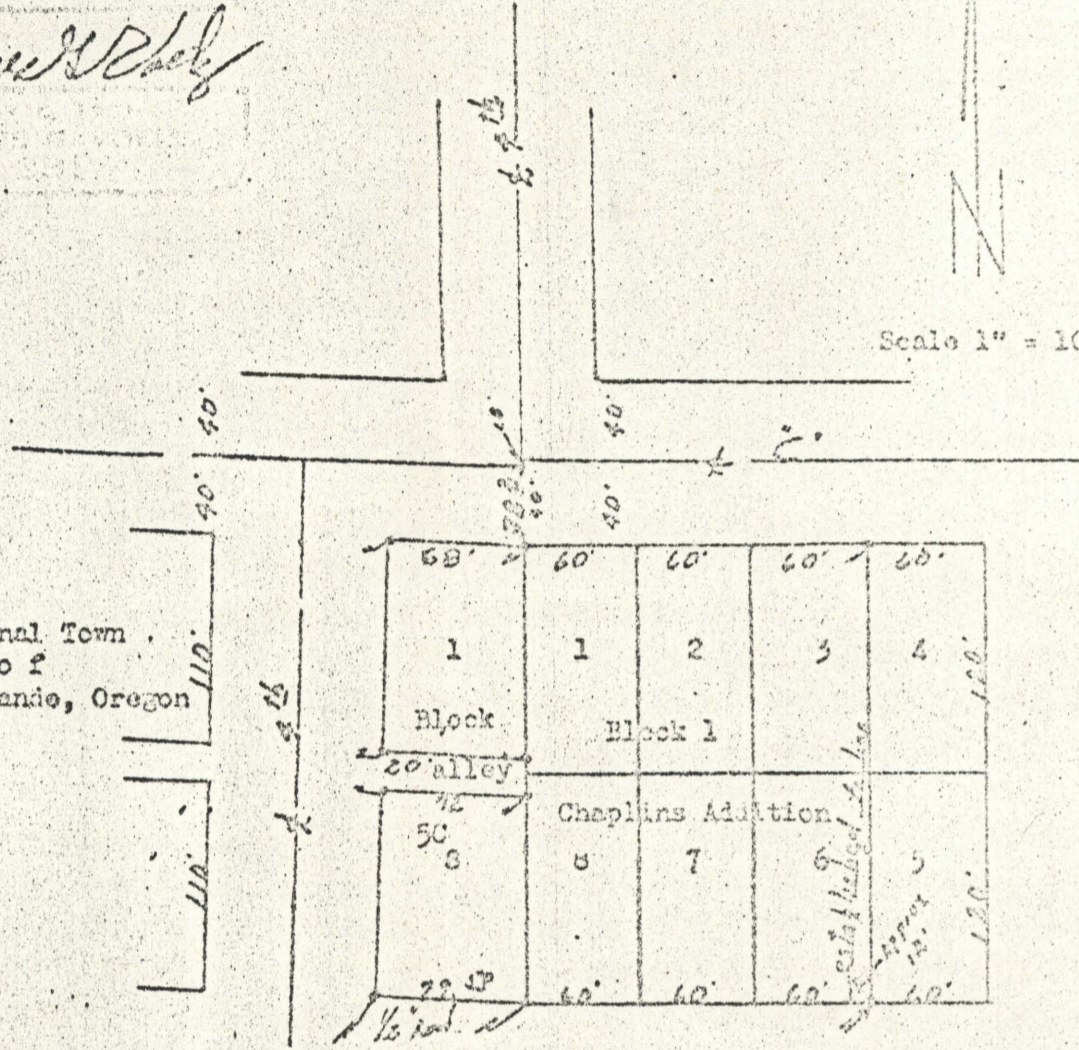

14-1962