

29-91

29-91

C. Smith

Survey for Wm. Lovan  
506-1/2 B St.  
La Grande, Oregon


May 20, 1962

Block 14 of Arnold's Addition

to B Ave

30' Cedar St

REGISTERED  
OREGON  
LAND SURVEYOR  
*James G. Voelz*  
MAY 4, 1936  
JAMES G. VOELZ  
331

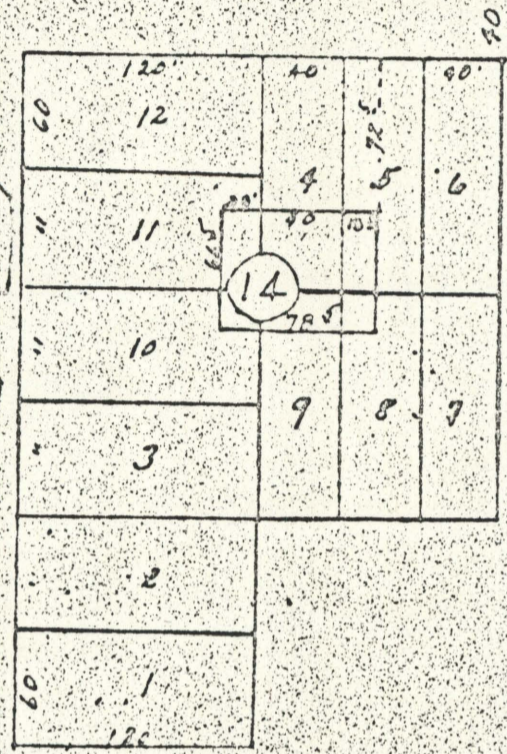

Description;  
 Beginning at a point on lot line between lots 4 & 5; said point being S 72° W 72.5 ft. from NE corner of lot 4 of Block 14 of Arnold's Addition to La Grande, Oregon.  
 Th. S 87° E 18.5 ft.  
 Th. S 3° W 66.5 ft.  
 Th. N 3° W 78.5 ft.  
 Th. N 3° E 66.5 ft.  
 Th. S 87° E 60 ft. to point of beginning.  
 Said parcel of land being in lots 4, 5, 6, 7, 8, 9, 10 & 11.

16-1962