

27-61


27-61

Carl Linn

Survey for Dave Larson
La Grande, Oregon.

2" Iron pipe
1/4 Cor.

No. East Cor. Sec. 18, T-3-S, R-38-E1M.

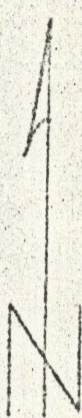


Survey completed May 6, 1962

Scale 1" = 200'

Description;

Beginning at a point 2335.97 feet South and 126.65 feet east
of North 1/4 corner of Section 18, T-3-S, R-38-E1M
thence S 21° 39' 35" W 240 feet;
thence N 71° 28' 55" W 308.5 feet, more or less, to east edge of Morgan Lake
County Road;
thence northerly along the east edge of said road to a point
which N 76° 41' 25" W 401 feet more or less from point of beginning.
thence S 76° 41' 25" W to said described point of beginning.

The parcel of land so described is situated in
SE 1/4 NW 1/4 Section 18, T-3-S, R-38-E1M.

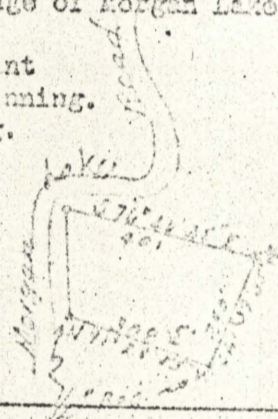

Point of
Beginning
2335.97 ft.
South and
126.65 ft.
East of N
1/4 cor.

WESTERN
OREGON
LAND SURVEYOR
James D. Tooley
MAY 1962
LA GRANDE, OREGON

19-1962