


5-63

59-5

905 Spring Ave. La Grande, Oregon

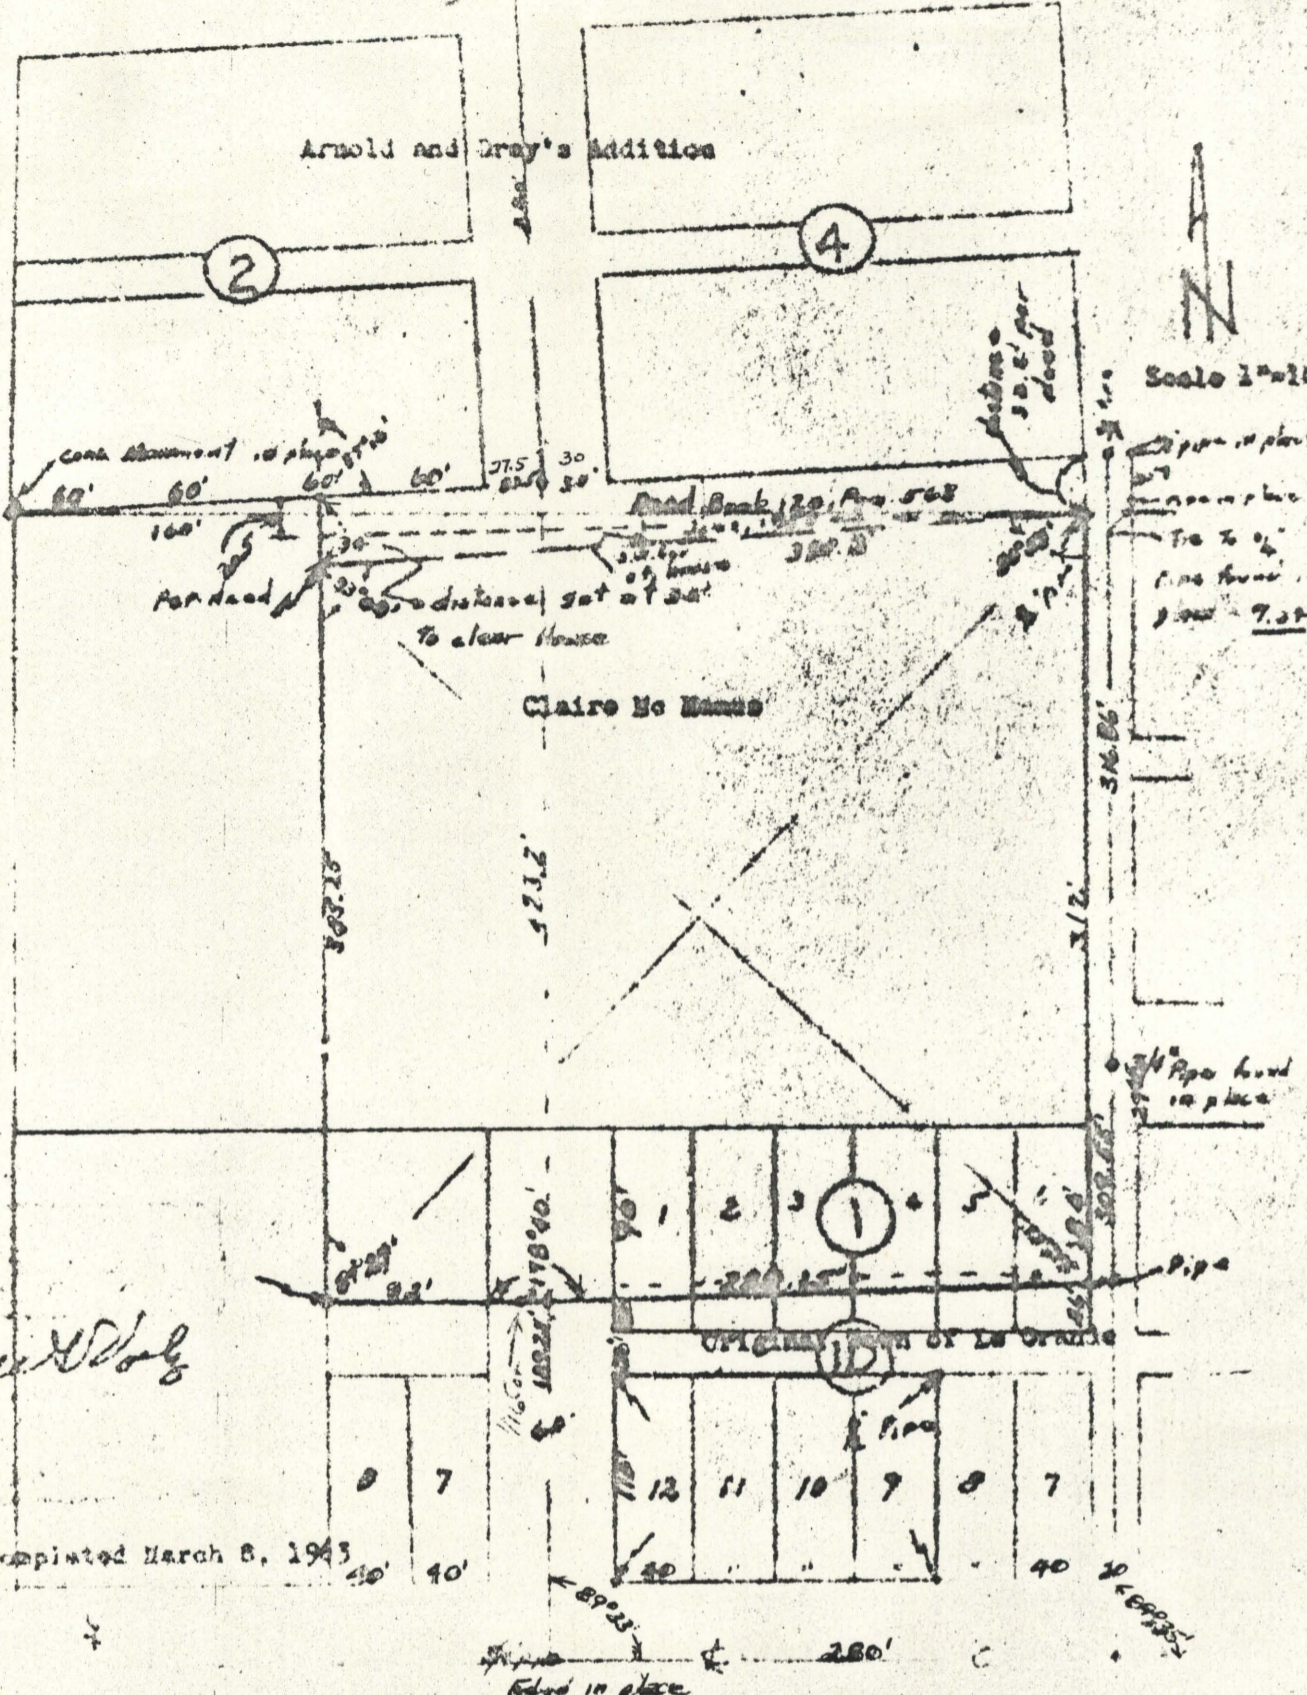

James Wolf

Survey completed March 8, 1943

5-63