

SITE SURVEY ZION LUTHERAN CHURCH


La Grande, Oregon

Scale 1" = 20'

Date Nov. 22, 1963

Lots 5, 6, 7, 8, 9, & 10 Block 89 Chaplins Addition to La Grande, Oregon

REGISTERED
OREGON
LAND SURVEYOR
James D. Dole
MAY 4, 1958
391

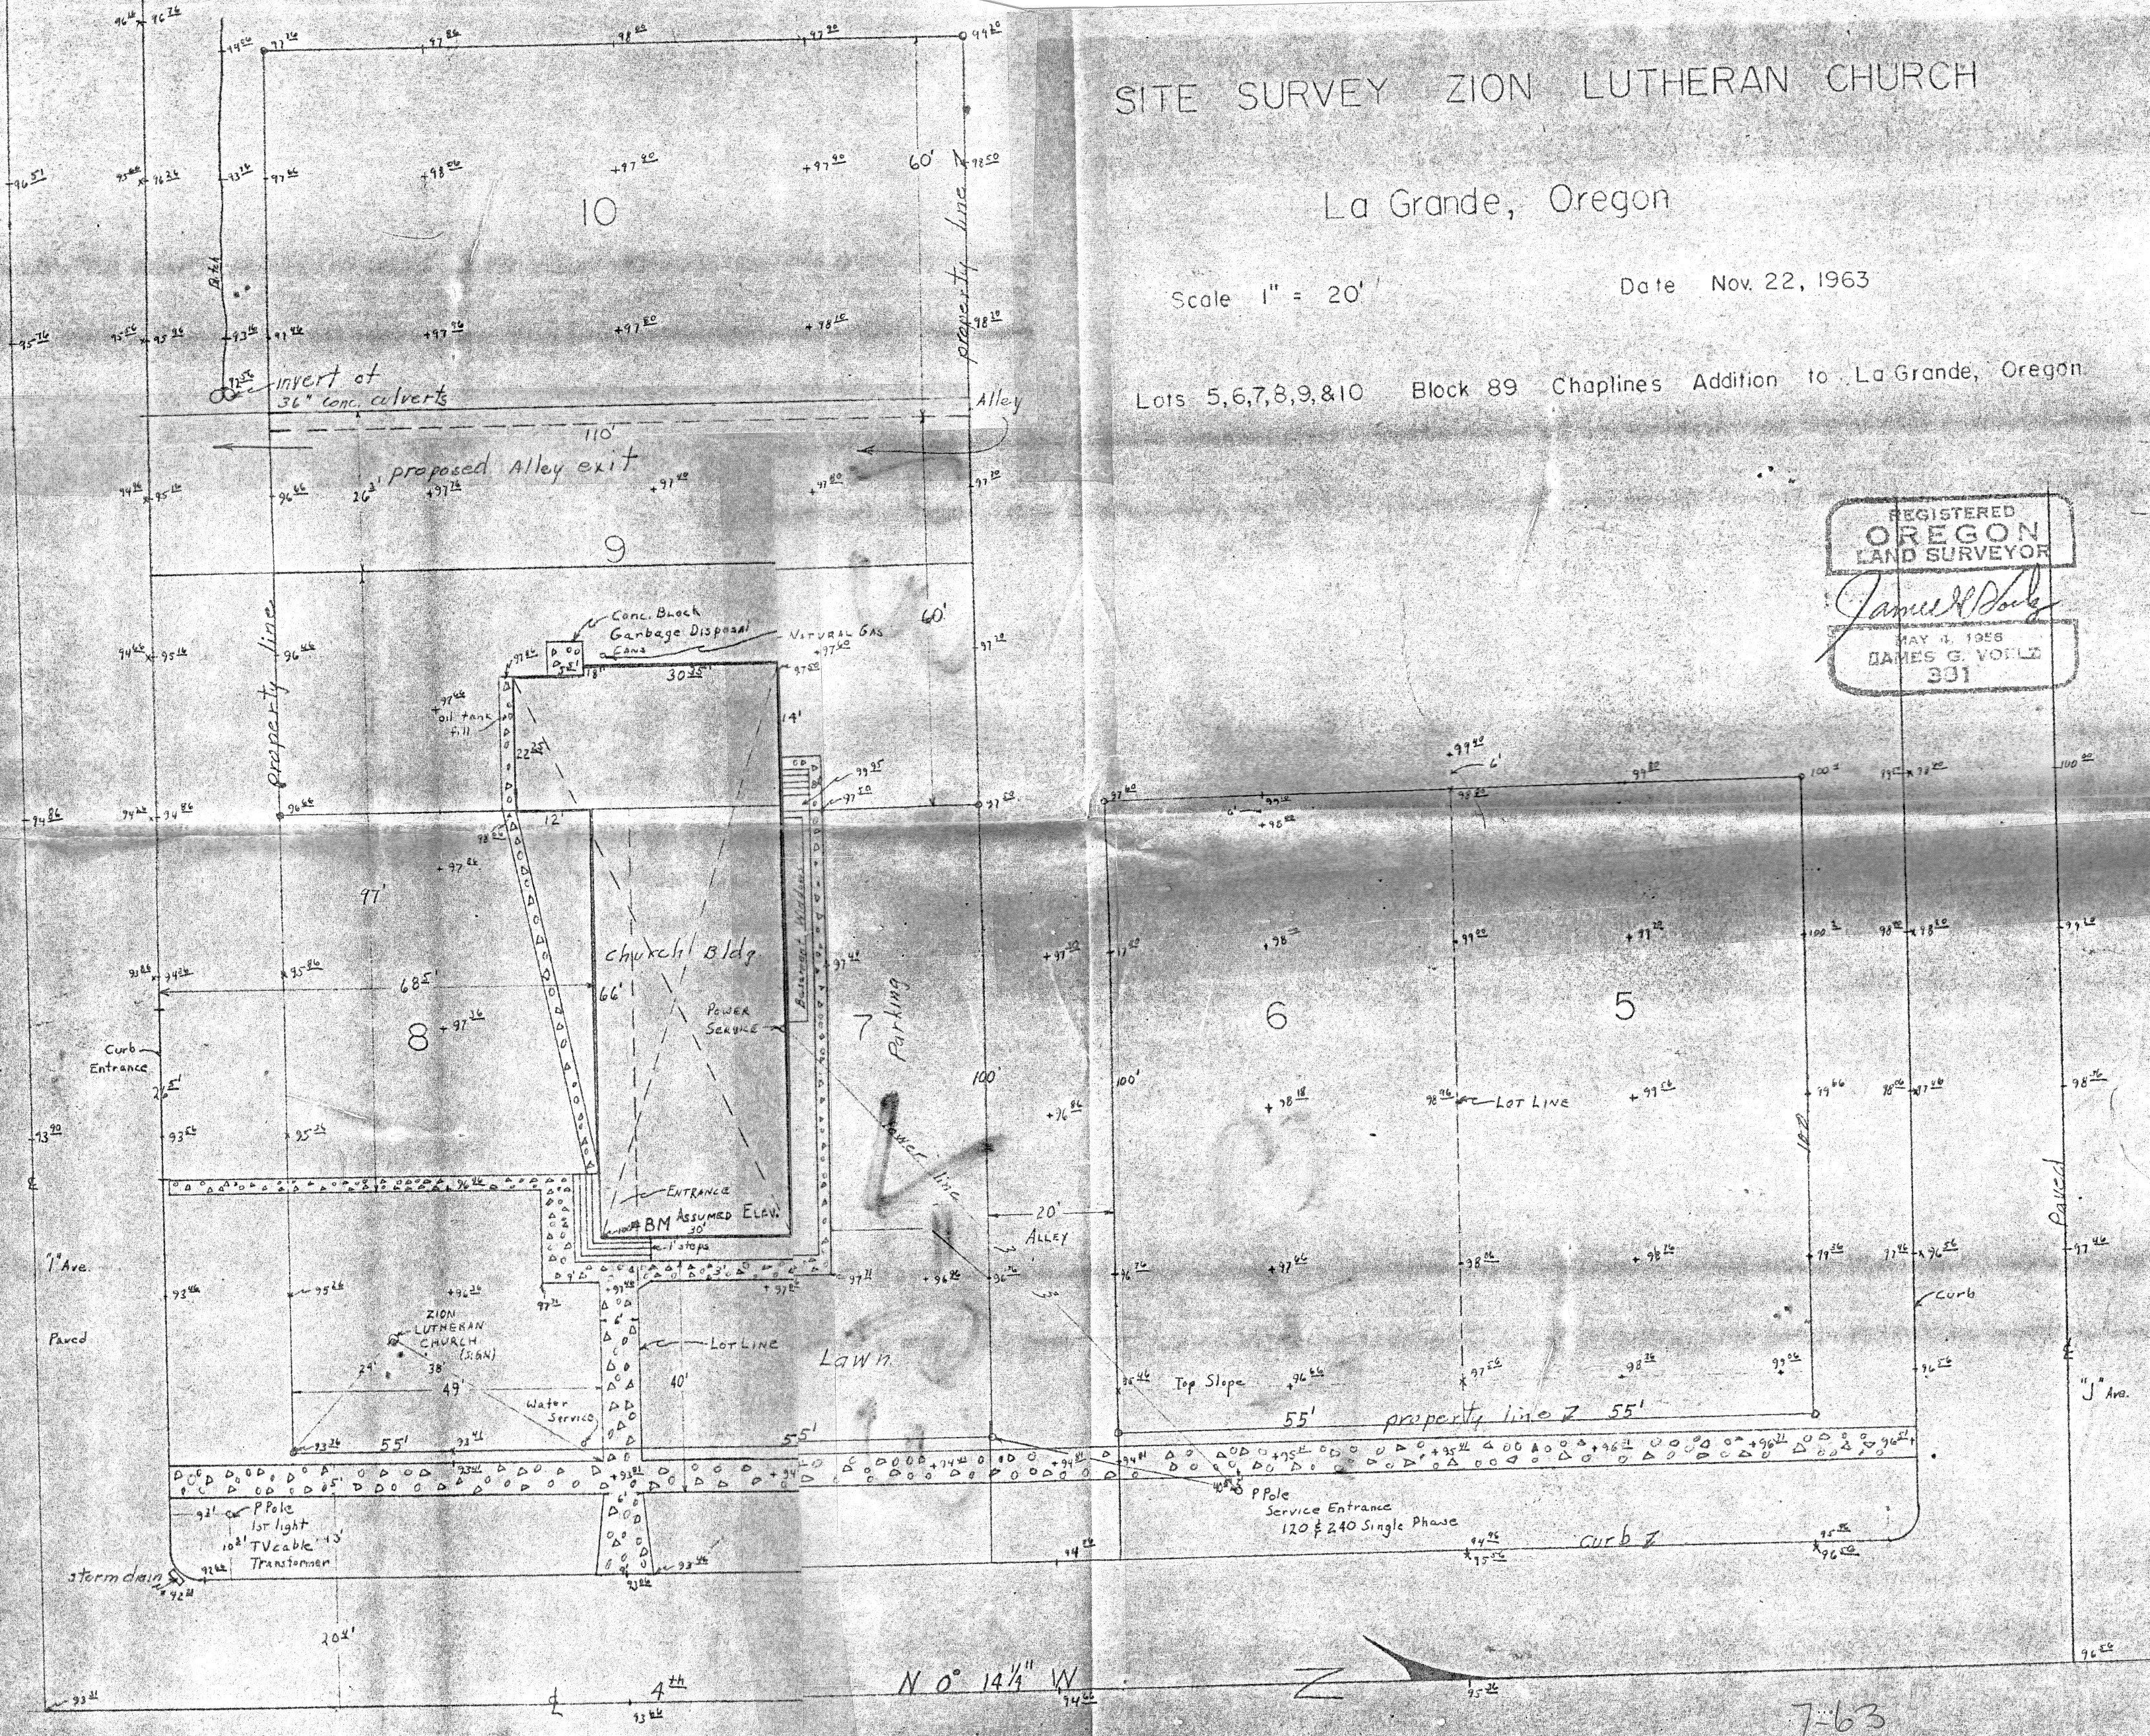

7-63