


Survey for La Grande Cemetery

Date- August 10, 1963

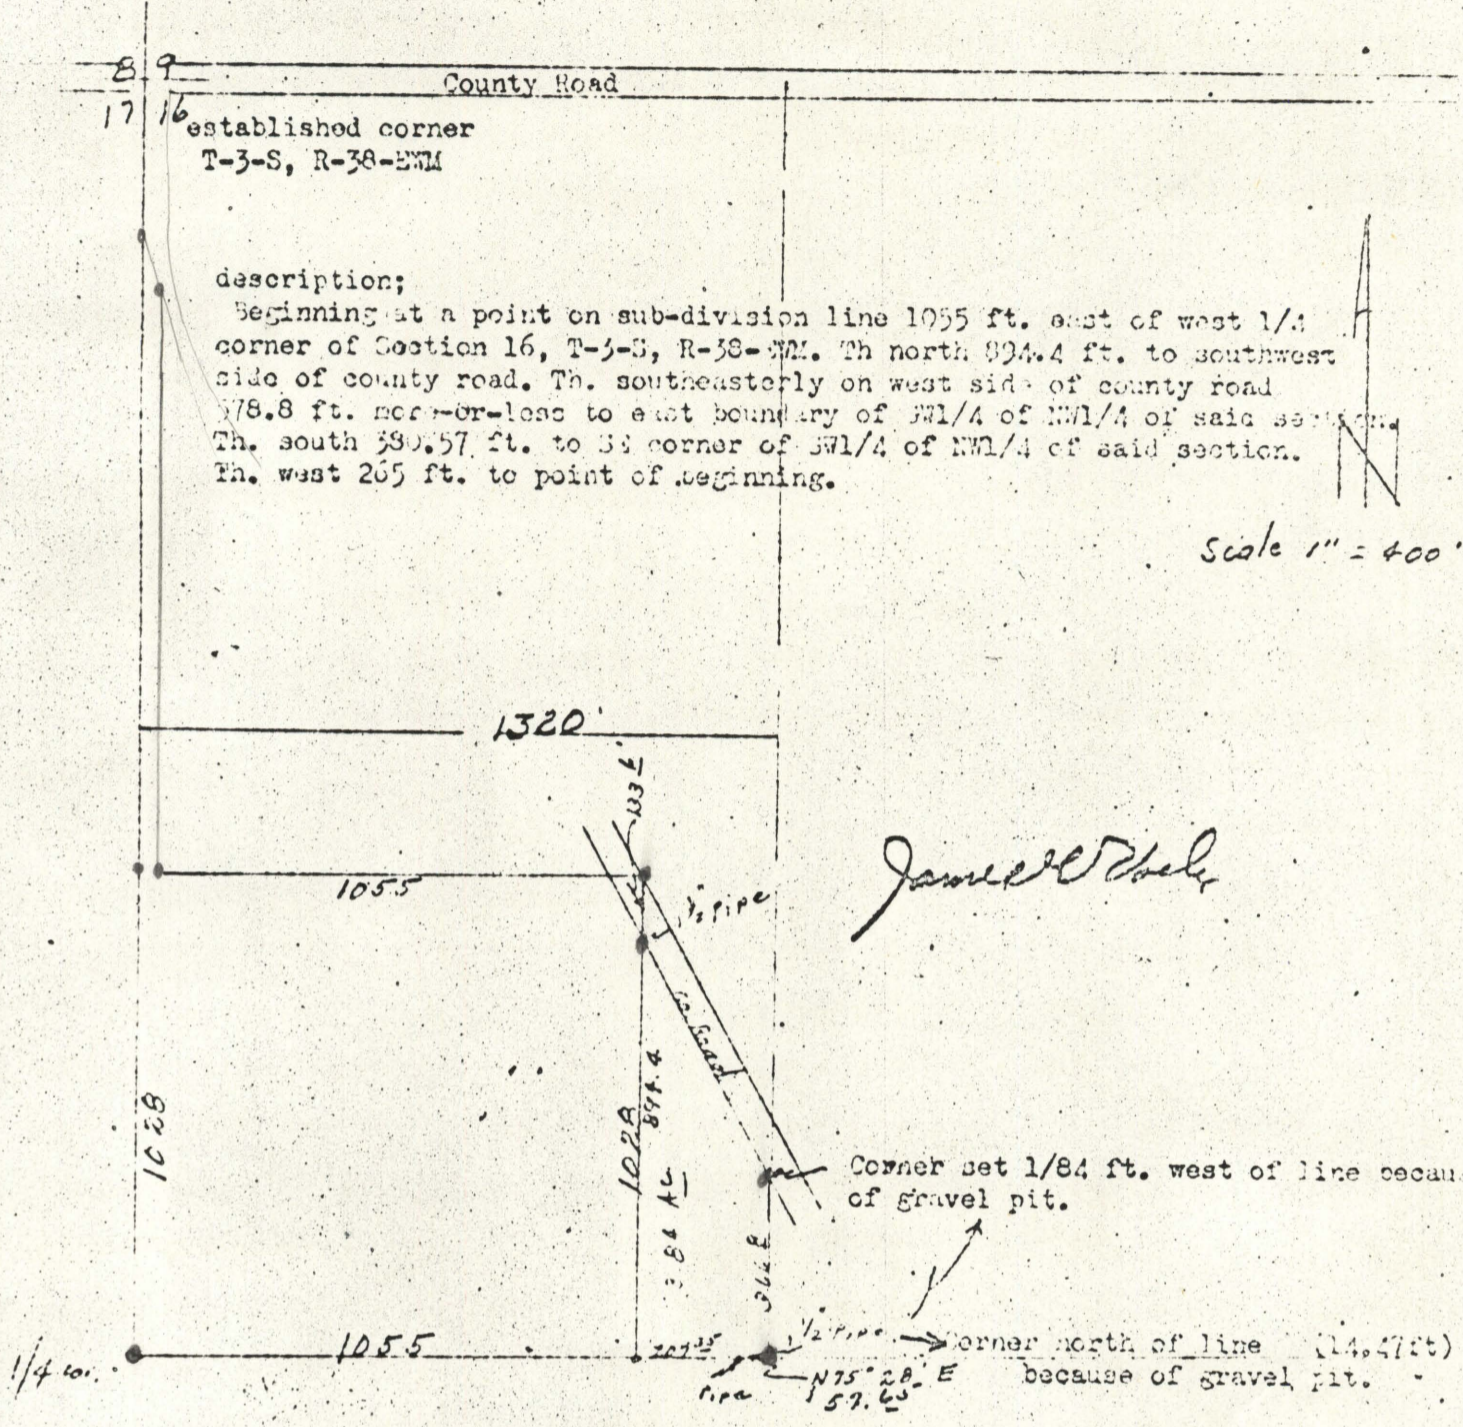

8-1963