


9-6  
C/

9-6


Survey for Bob Clemons  
S 12 th. St.  
La Grande, Oregon

Date June 15, 1963

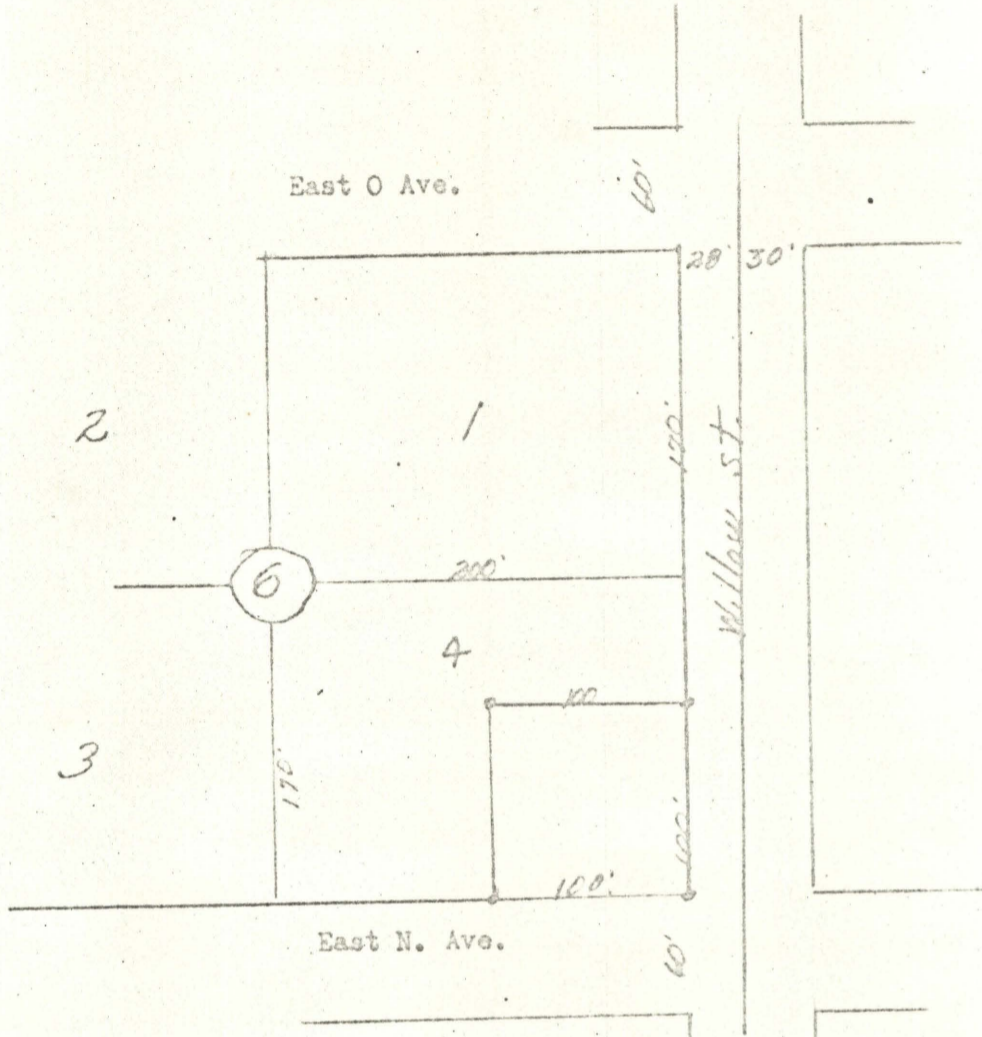

Description

The east 100 ft. of South 100 ft. of lot 4  
of Block 6 of Honan's Addition to La Grande, Oregon.

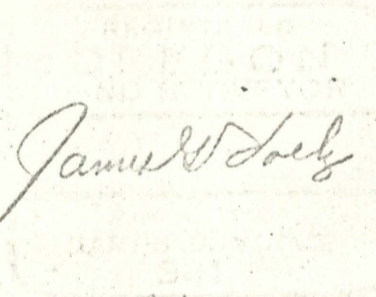  
 James W. Sochy  
 State of Oregon  

9-1963