

12-63

12-63


C. House

Survey for Daisy Mc Neal Estate


S Vern Newkirk  
501 A - St.  
La Grande, Oregon

Date-- June 4, 1963

Description ; All of Out Lot numbered two (2) of the Original government townsite plat of LeGrand; Excepting therefrom a strip of land 35 feet in width across the north side, and excepting a strip of land 10 feet in width across the entire south side of said OUT LOT.

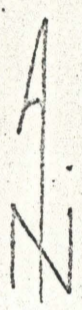

Scale 1" = 200'

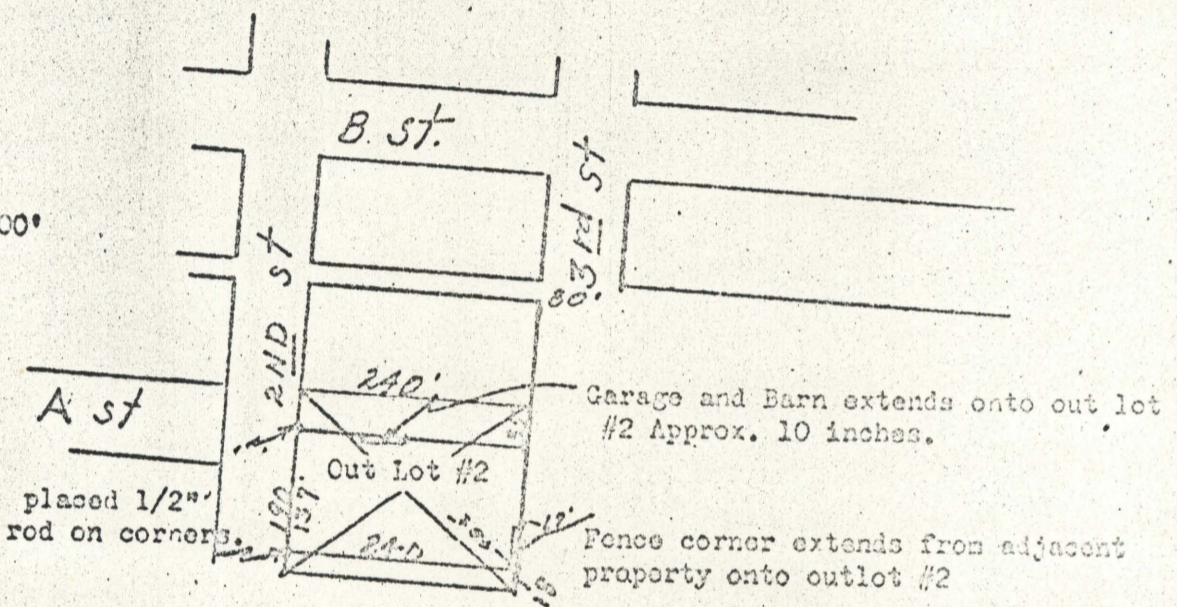

REGISTERED  
 JAMES D. DUBO  
 LAND SURVEYOR  
 1901 N. 1st St.  
 La Grande, Oregon

12-1963