


13-63


Survey For Beeline Refining Co.
P.O. Box 175
North Salt Lake, Utah

sheet 1 of 2

Date June 11, 1963

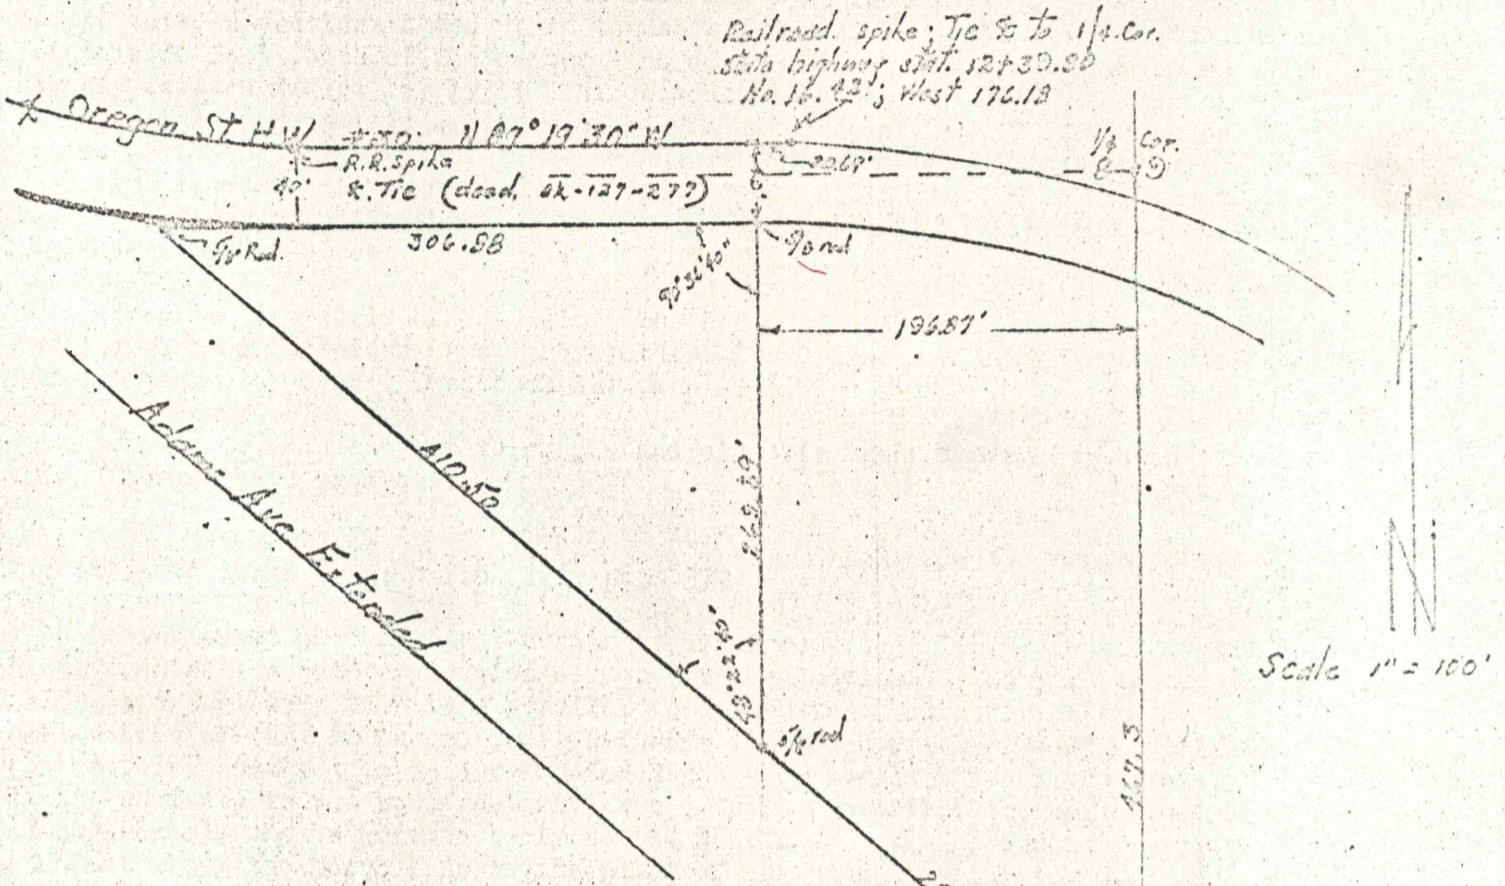

This survey was completed by me on June 11, 1963.
I do not find encroachment of adjoining property on to surveyed property nor described property onto adjoining property. Ties were made to adjoining properties as shown.

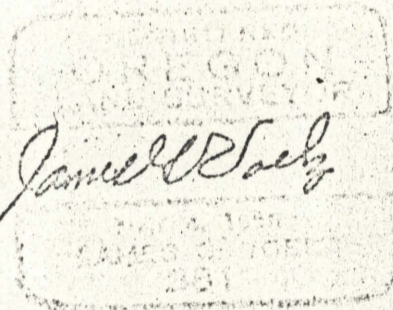

 JAMES D. SALY

point of beginning
S. E. cor. Sec 8
T-3-S R-38-E-W-M
Ref. loc.

13-1963