


15-63

15-63

Survey for Davis Brothers
Union, Oregon

April 1, 1963

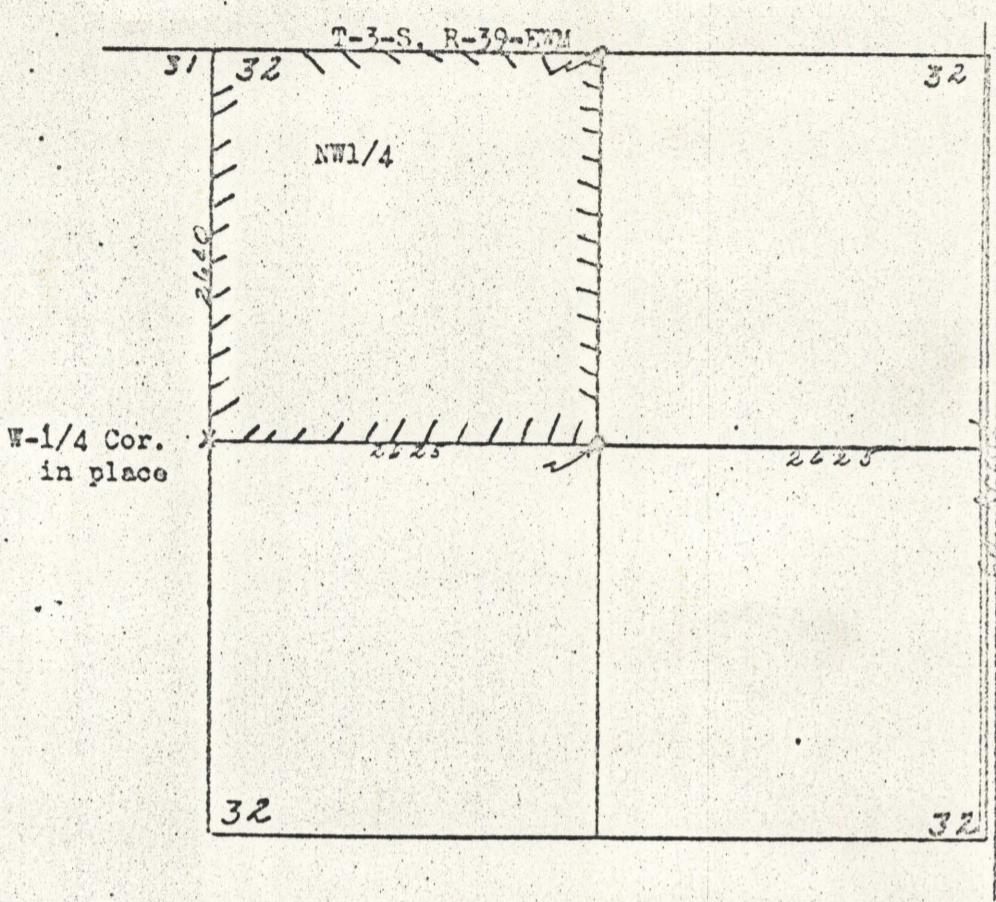

Description

NW 1/4 of Section 32, T-3-S, R-39-EWM

James D. W. Coyle

15-1963