
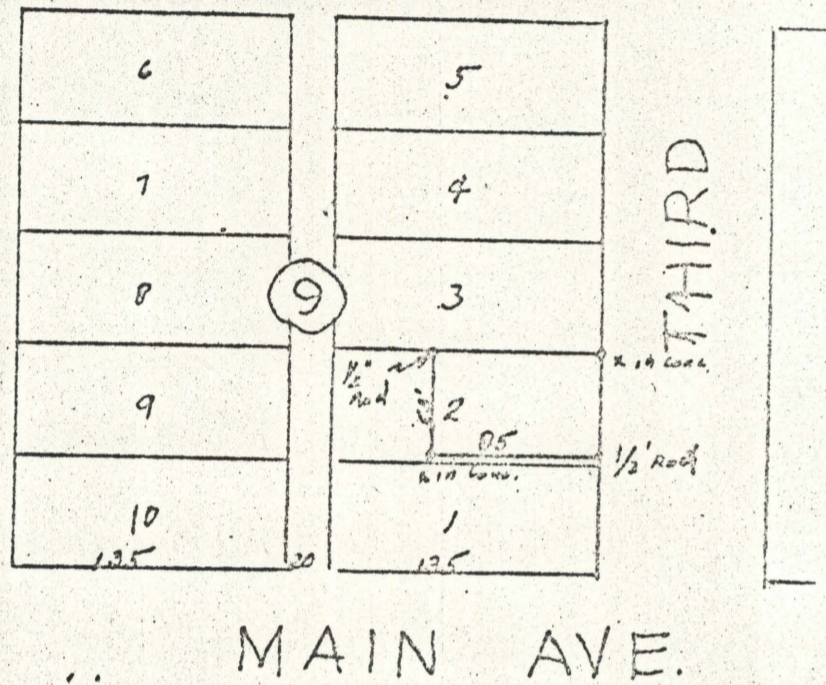


16-63

16-63

Survey for MRS. John T. Trimble.  
1804 Third St.  
La Grande, Oregon

April 20 1963

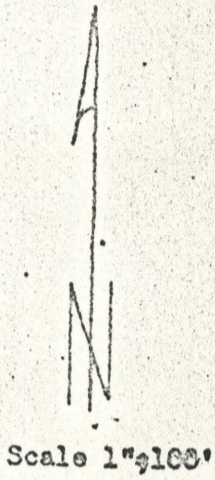

Description;  
The north 53' of east 85' of Lot 2 Block 9 of Grandy's Addition  
to La Grande, Oregon.

James H. Selig  
MAY 4 1963  
JAMES H. SELIG  
301

16-1963