E9-81

E9-81

Survey for Claire Mc Manus

905 Spring Ave. La Grande, Oregon

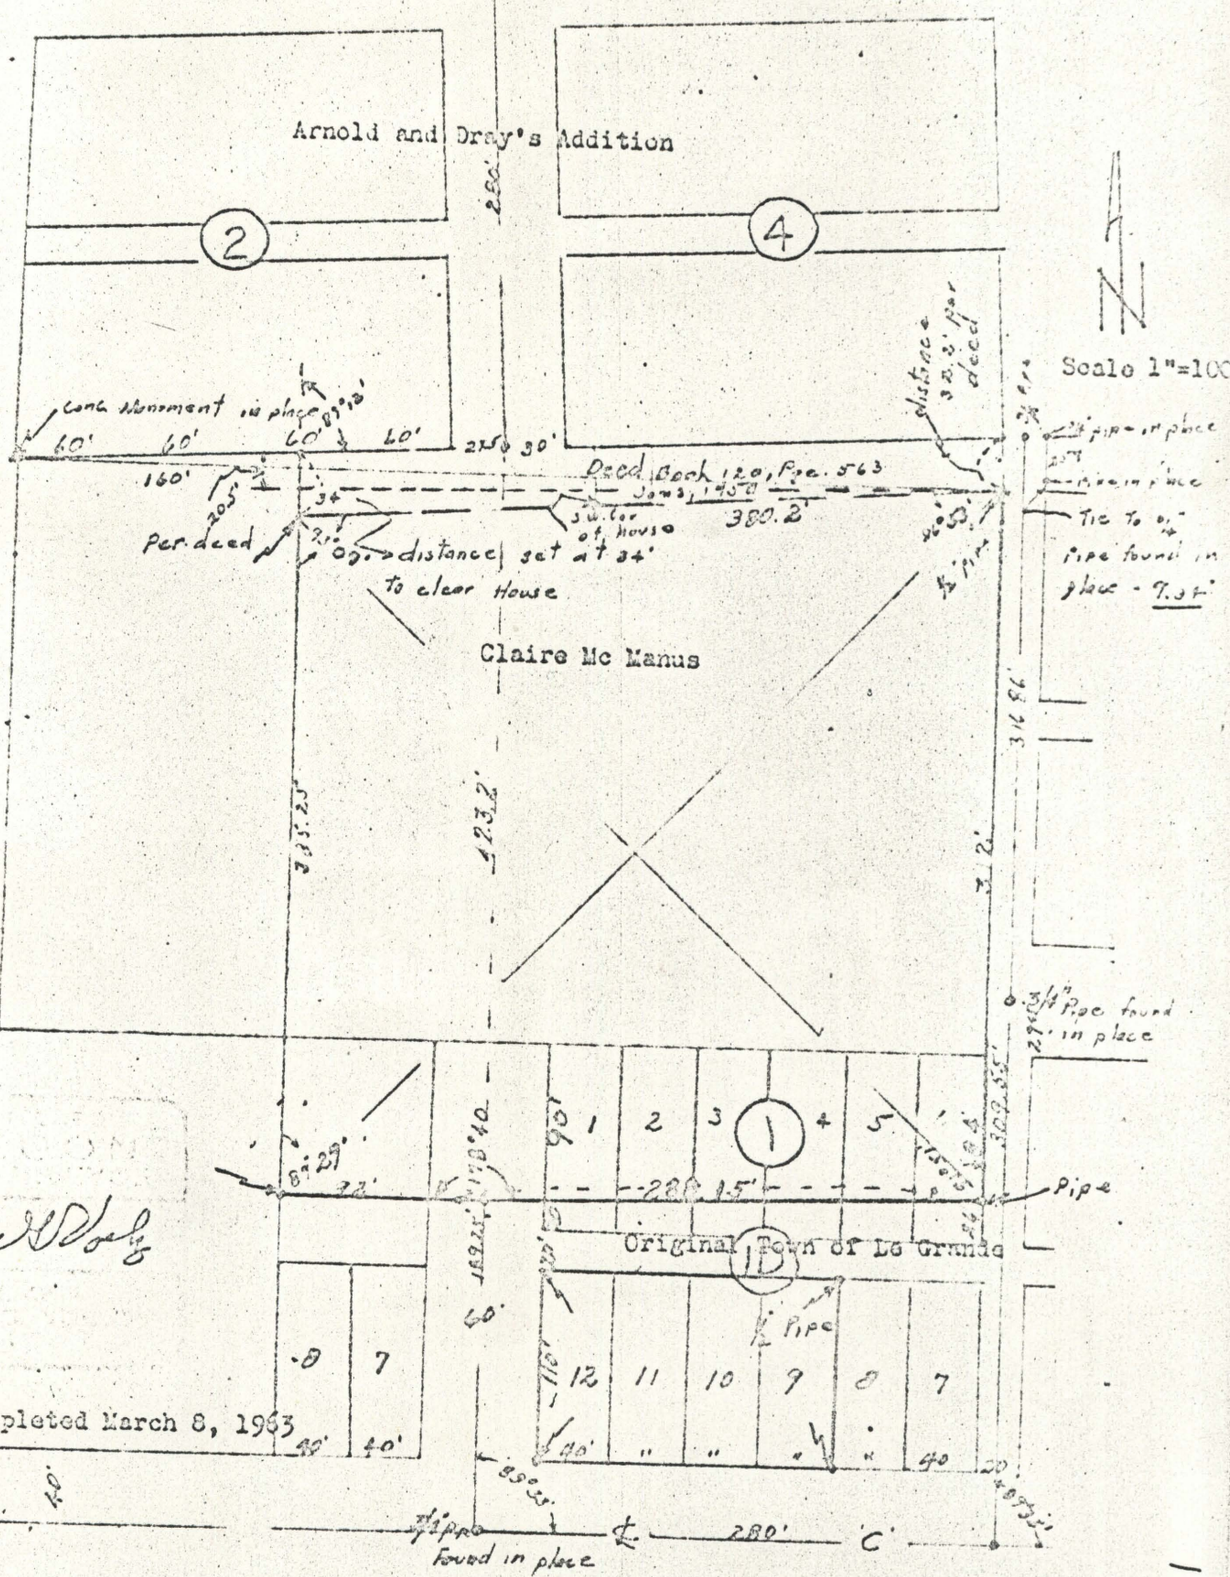

James W. Lee

Survey completed March 8, 1963

18-1963