


19-63

19-63

Survey of Lots one and four
Block two Honan's Addition
La Grande, Oregon

Surveyed Feb. 26, 1963

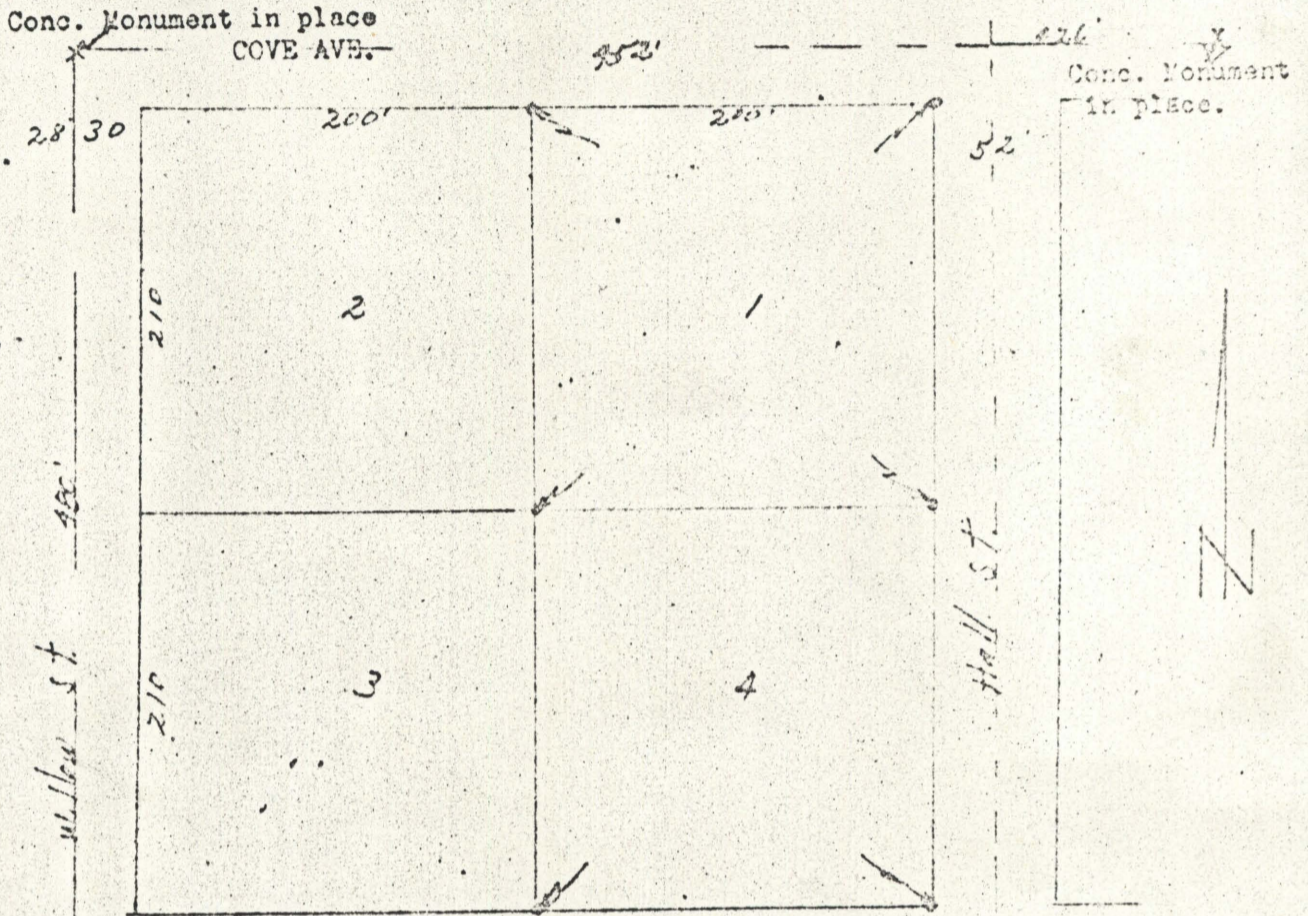

3/4" pipe found in place

Note: Willow St. and Hall St. are not the width as shown in Original Plat. Authority for width as shown is, on plat in City Engineers records in City Hall, La Grande, Oregon.

James R. Kelly

19-1963