


Survey for
Hoak and Clark

Hoak Rt. #1 Box 235, La Grande, Oregon
Clark Rt. #1 Box 333, La Grande, Oregon

Date December 3, 1963

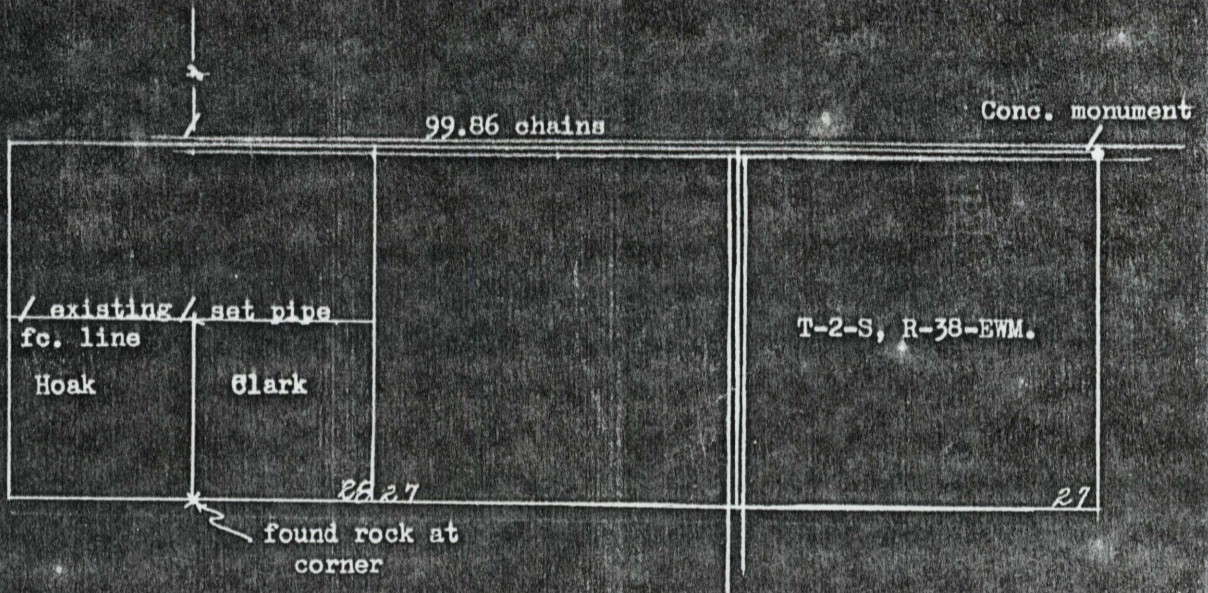

REGISTERED
OREGON
LAND SURVEYOR
James G. Voelz
MAY 4, 1956
JAMES G. VOELZ
381

DEC 3 1963

27-63

27-63