

3-64


0-955

0-9595

107164 4" Gas pipeline King  
encased in 8"x30" casing pipe 4'x6'0"

11-97" Pipe res. under tank  
Pressure Box  
12"x28" Power line string

17-30 Con. 4'x6'0"

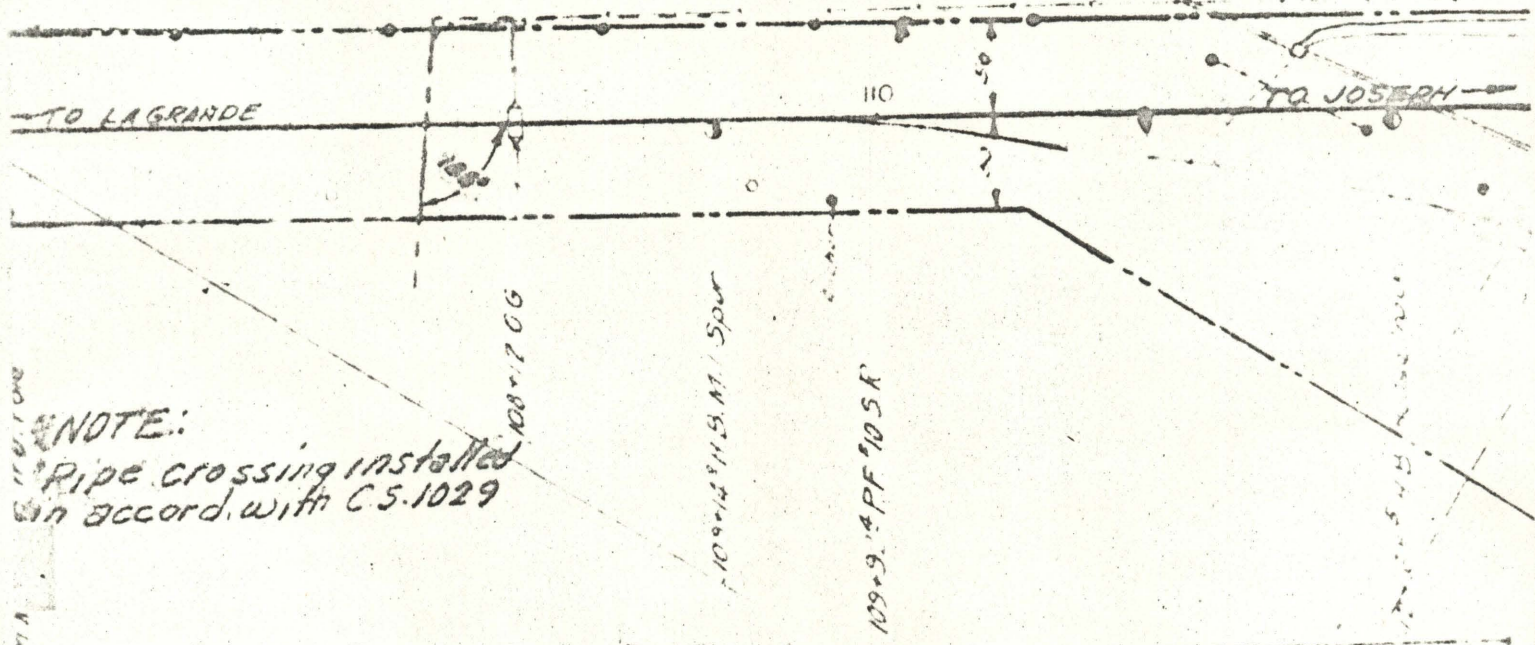

NOTE:  
Pipe crossing installed  
in accord. with C.S. 1029

25 38 34

EXHIBIT  
 OREGON WASHINGTON RAILROAD & NAVIGATION CO.  
 (LESSEE)  
 ISLAND CITY, OREGON

To accompany agreement with California-Pacific Utilities Company covering underground gas pipe line crossing.

\* LEGEND \*

Gas pipe line crossing shown - DASHED RED

1" = 100'

Jan. 28, 1964

3-64