55386DC 16600

11-64

Survey for

G.M. & S.V. Hill
1601 Alder St.
La Grande, Oregon

Date survey August 20, 1964

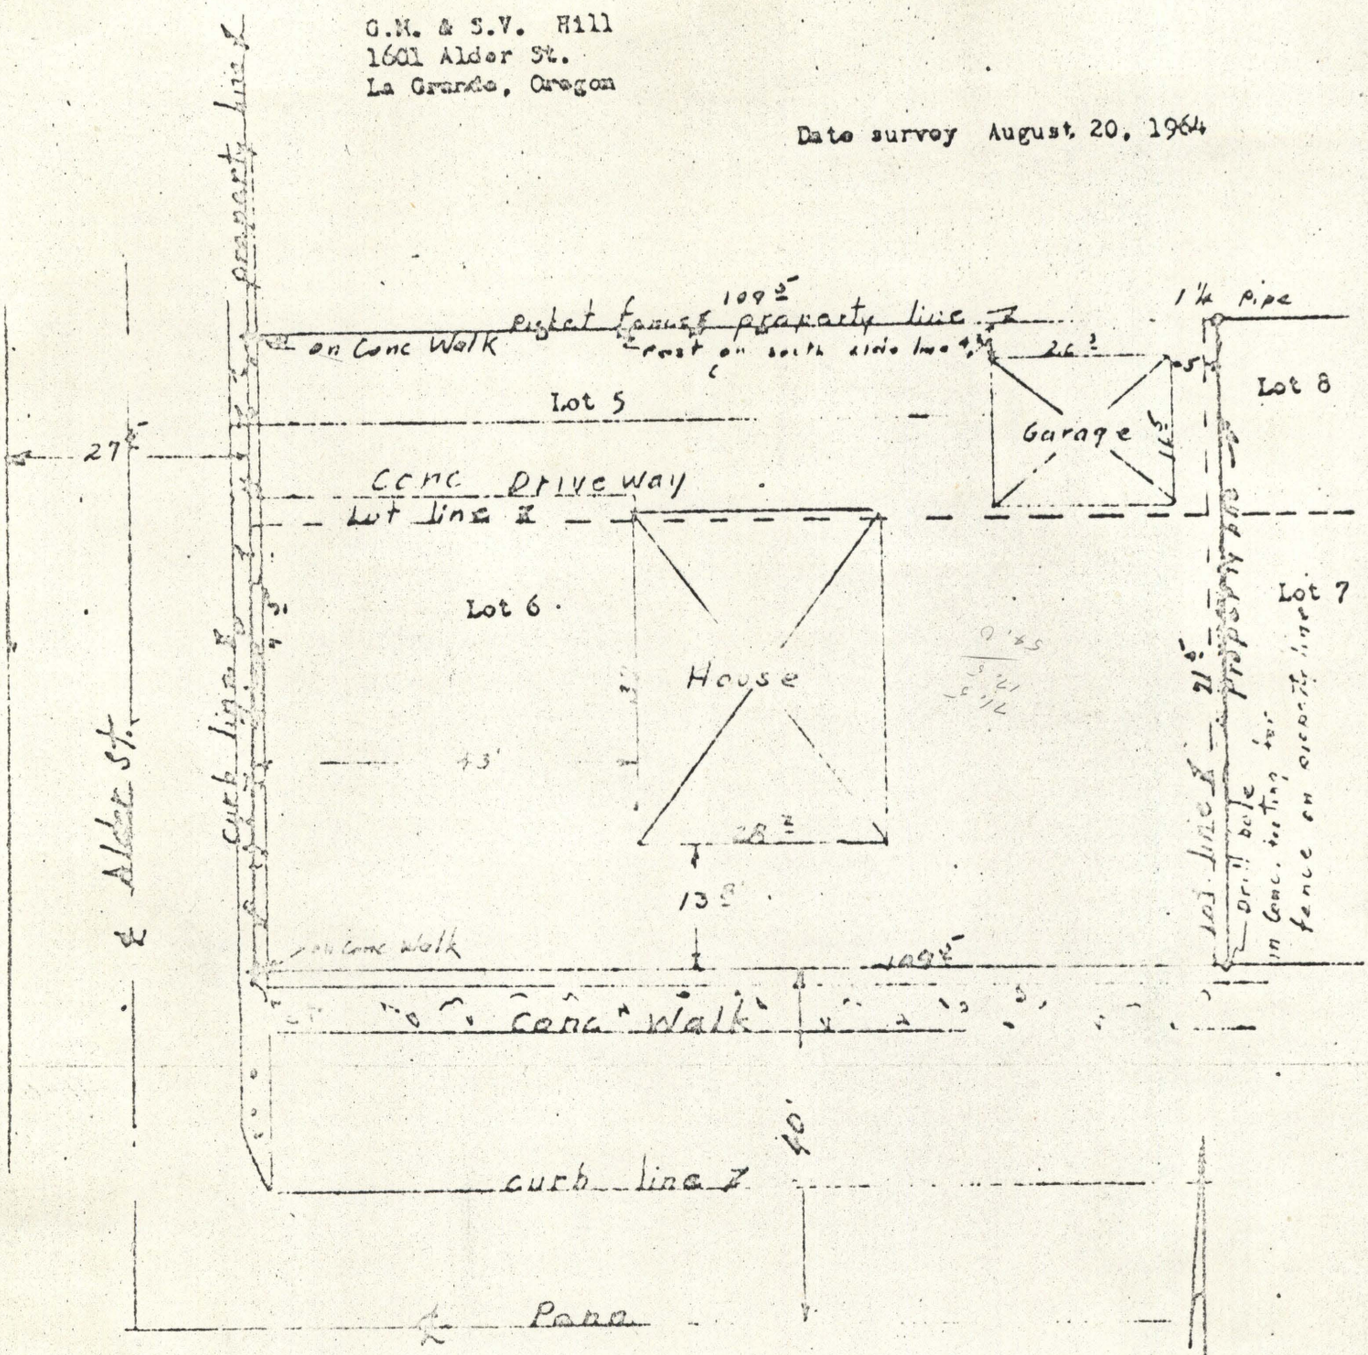

Description: Commencing at a point on the south line of Block 10 of Romig's Addition to La Grande, Union County, Oregon, 108½ feet west of the southeast corner of said Block; running thence west along the south line of said block a distance of 109½ feet to the east line of Alder Street; thence north along the east line of Alder Street 71½ feet; thence east parallel with the south line of said block 109½ feet; thence south 71½ feet to the point of beginning.

Being all of lot 6, and a portion of lots 5, 7 and 8 of Block 10 of Romig's Addition to La Grande, Oregon.

I certify this survey was made by me on August 20, 1964 and there are no encroachments or overlaps except as shown.

REGISTERED
OREGON
LAND SURVEYOR
James M. Doty
1958
VOFC7
351

11-64