

7-21

3 38 888 5600


12-64

7-21

Survey for Ronald D. & Verna Carroll

Description: Lot 5 of Block 61 of Chaplin's Addition to La Grande, Oregon.

Date- August 12, 1964

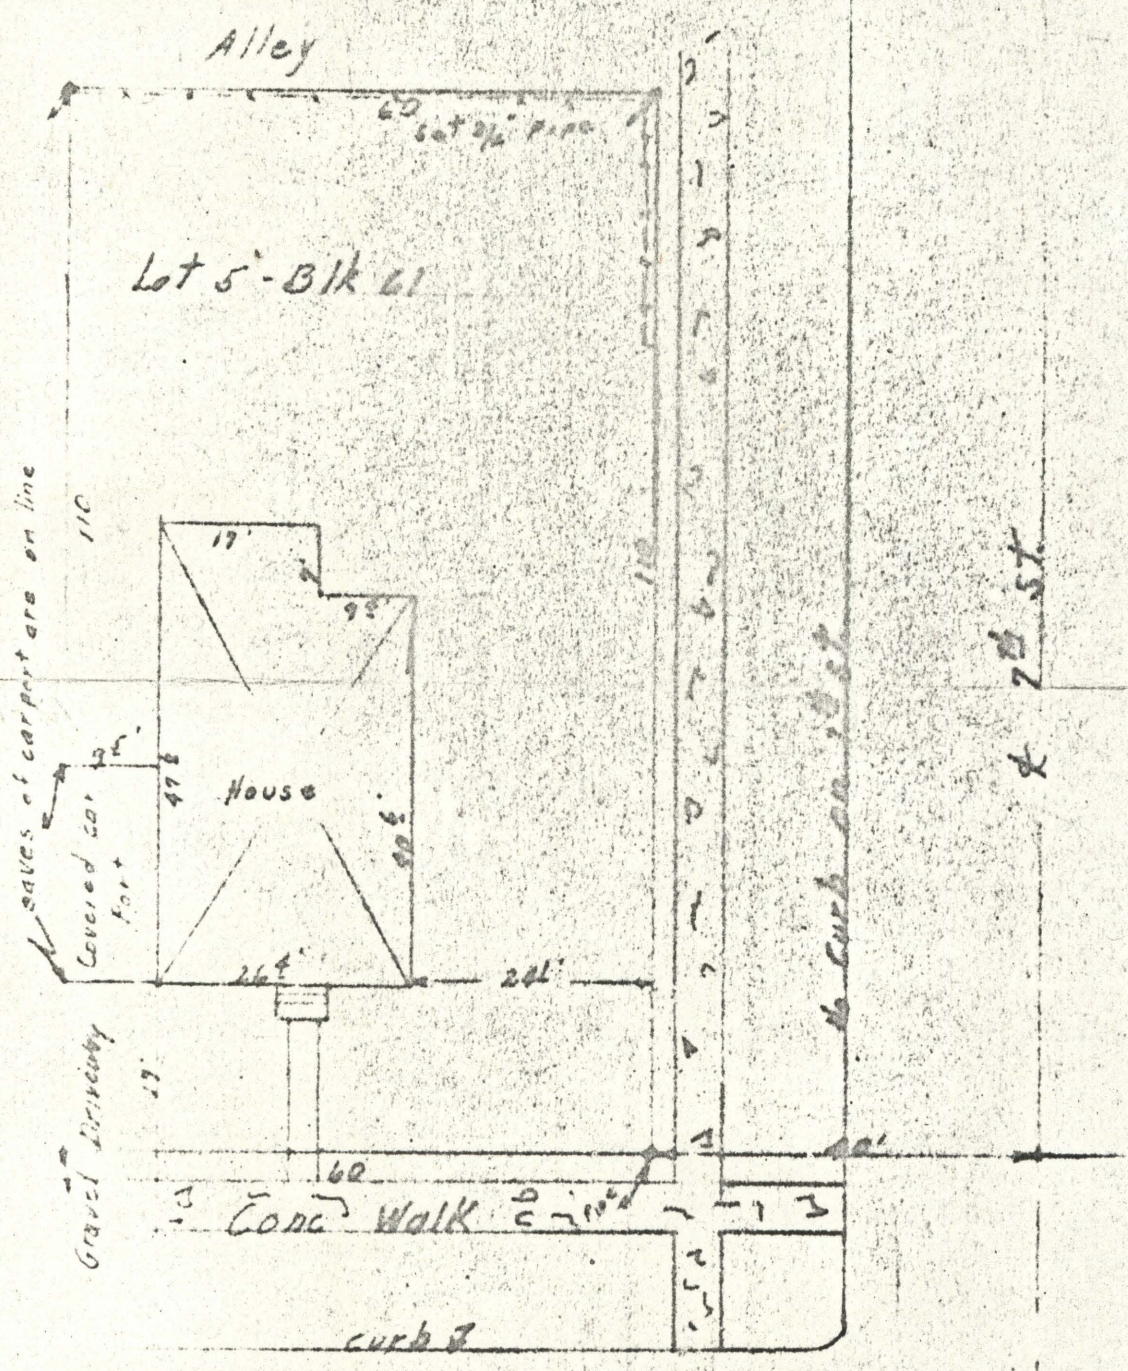

↑
A
N
↓
Scale 1" = 20'

± N Paved

I certify this survey completed by me on August 12, 1964 and there are not any encroachments on to the surveyed property nor does the surveyed lot approach any adjoining property.

Ronald D. Carroll
 Verna Carroll

12-64