


79-61

3s 38 7DC 2905

Date-- September 15, 1964

Block 15

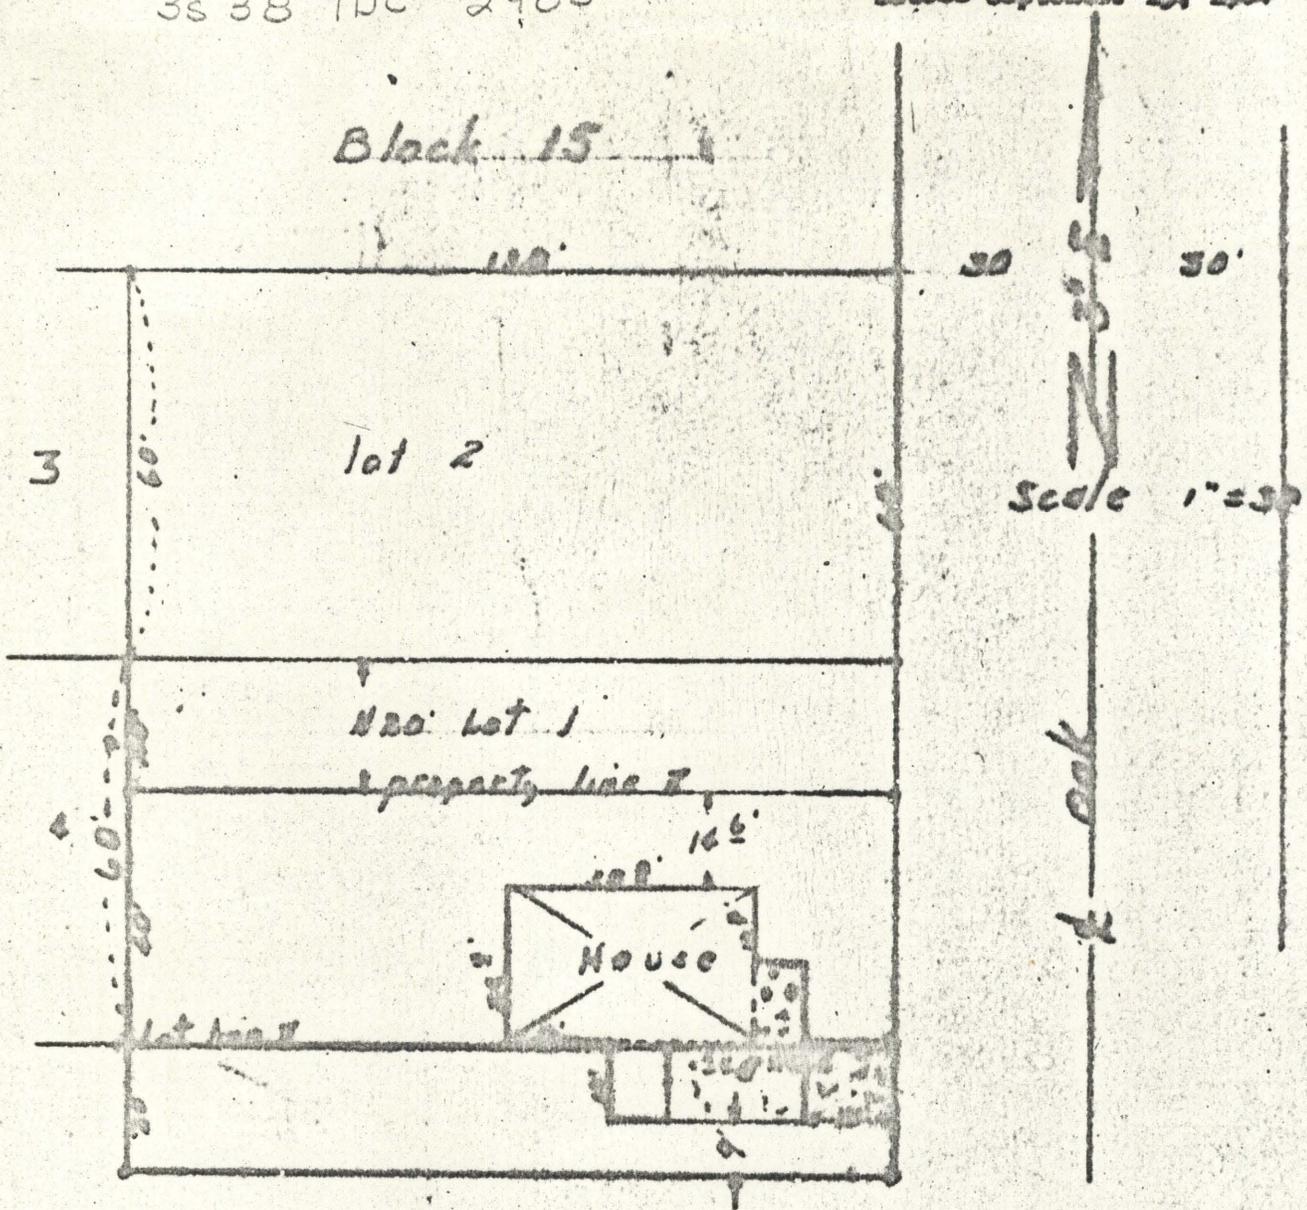

Description: The south forty (40) feet of Lot numbered one (1) in Block numbered 15 of Arnold's Addition to La Grande, Union County, Oregon, according to the recorded plat of said addition; Also a parcel of land lying south of and adjoining said lot 1, described as commencing at the southeast corner of said Block 15 and running thence south 3° west a distance of 20 feet; thence north 87° west a distance of 120 feet; thence north 3° east a distance of 20 feet to the southwest corner of said lot 1; thence south 87° east along the southerly of said lot 1 Block 15, Arnold's Addition, a distance of 120 feet to the point of beginning.

I certify this survey was completed by me on September 15, 1964 and there are no encroachments of adjoining property onto surveyed property nor does surveyed property encroach onto adjoining property.

REGISTERED
OREGON
LAND SURVEYOR

[Signature]

19-64