


Survey for L. Lloyd
 2009 Adams Ave.
 La Grande, Oregon

Date of survey-- Sept. 1964

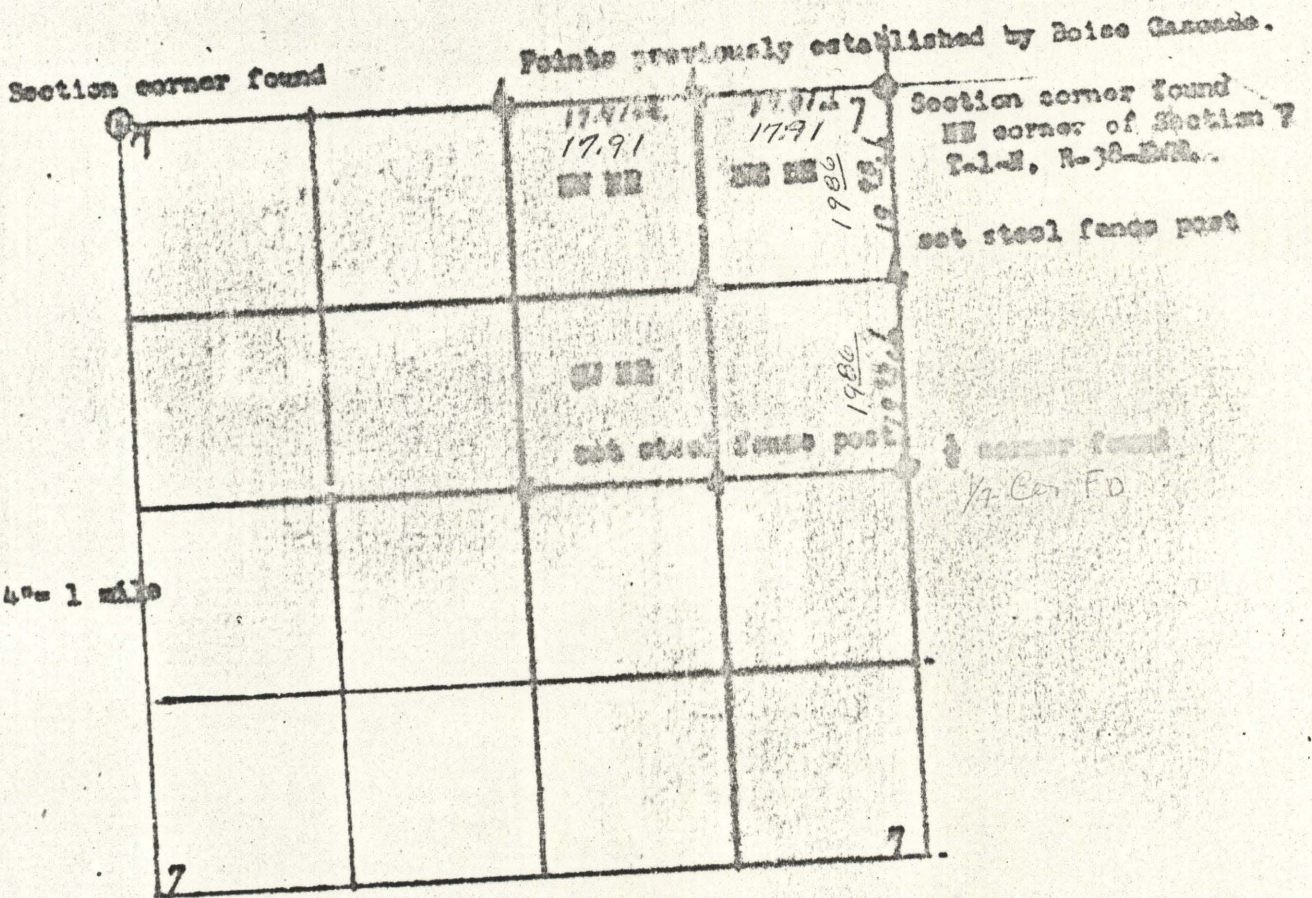

REGISTERED
 OREGON
 LAND SURVEYOR

James G. Voeltz

MAY 4, 1958
 JAMES G. VOELTZ
 381

23-64

23-64