


24-64  
C. House

Survey for Willard K. Carey  
907 N. Ave.  
La Grande, Oregon

Date survey-- October 13, 1964

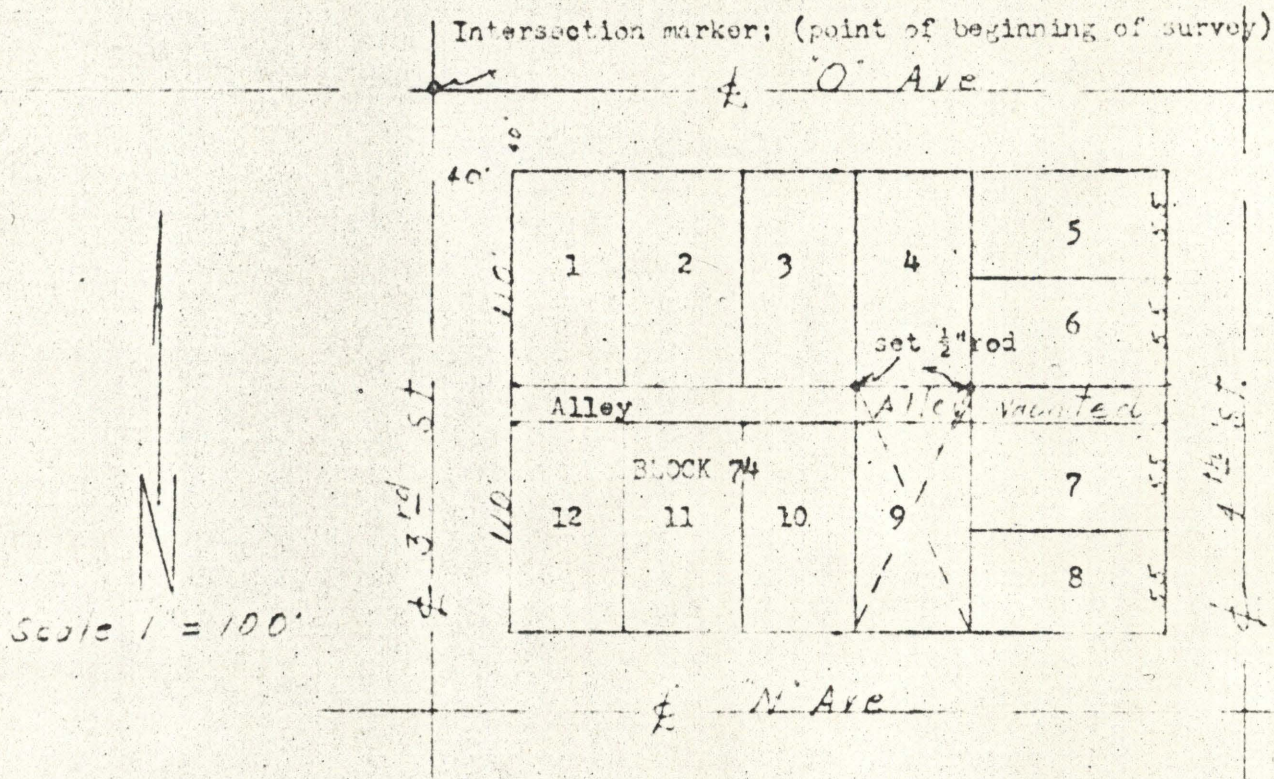

Description; Lot 9 of Block 74 of Chaplin's Addition to La Grande, Oregon and Alley between lots 9 and 4 of said Block 74.

Alley vacated by Ordinance #2041--1963 and recorded in Deed Book 147, page 626.

35387AA 5400

*Willard K. Carey*

24-64

24-64