


Survey of Grant Golder Property
 Deed dated August 2, 1943; Book 106 page 194.

Description;

Beginning at a point which is N89°40'W 962.3 feet and then S 0° 20' West 364.8 feet from NE corner of section 21, T-3- , R-40-ETL; thence S27°45'W a distance of 80 feet; thence S 62°15'W a distance of 150 feet; thence N 27°45'E a distance of 80 feet; thence S 62°15'E a distance of 150 feet to point of beginning.

scale 1"=200'

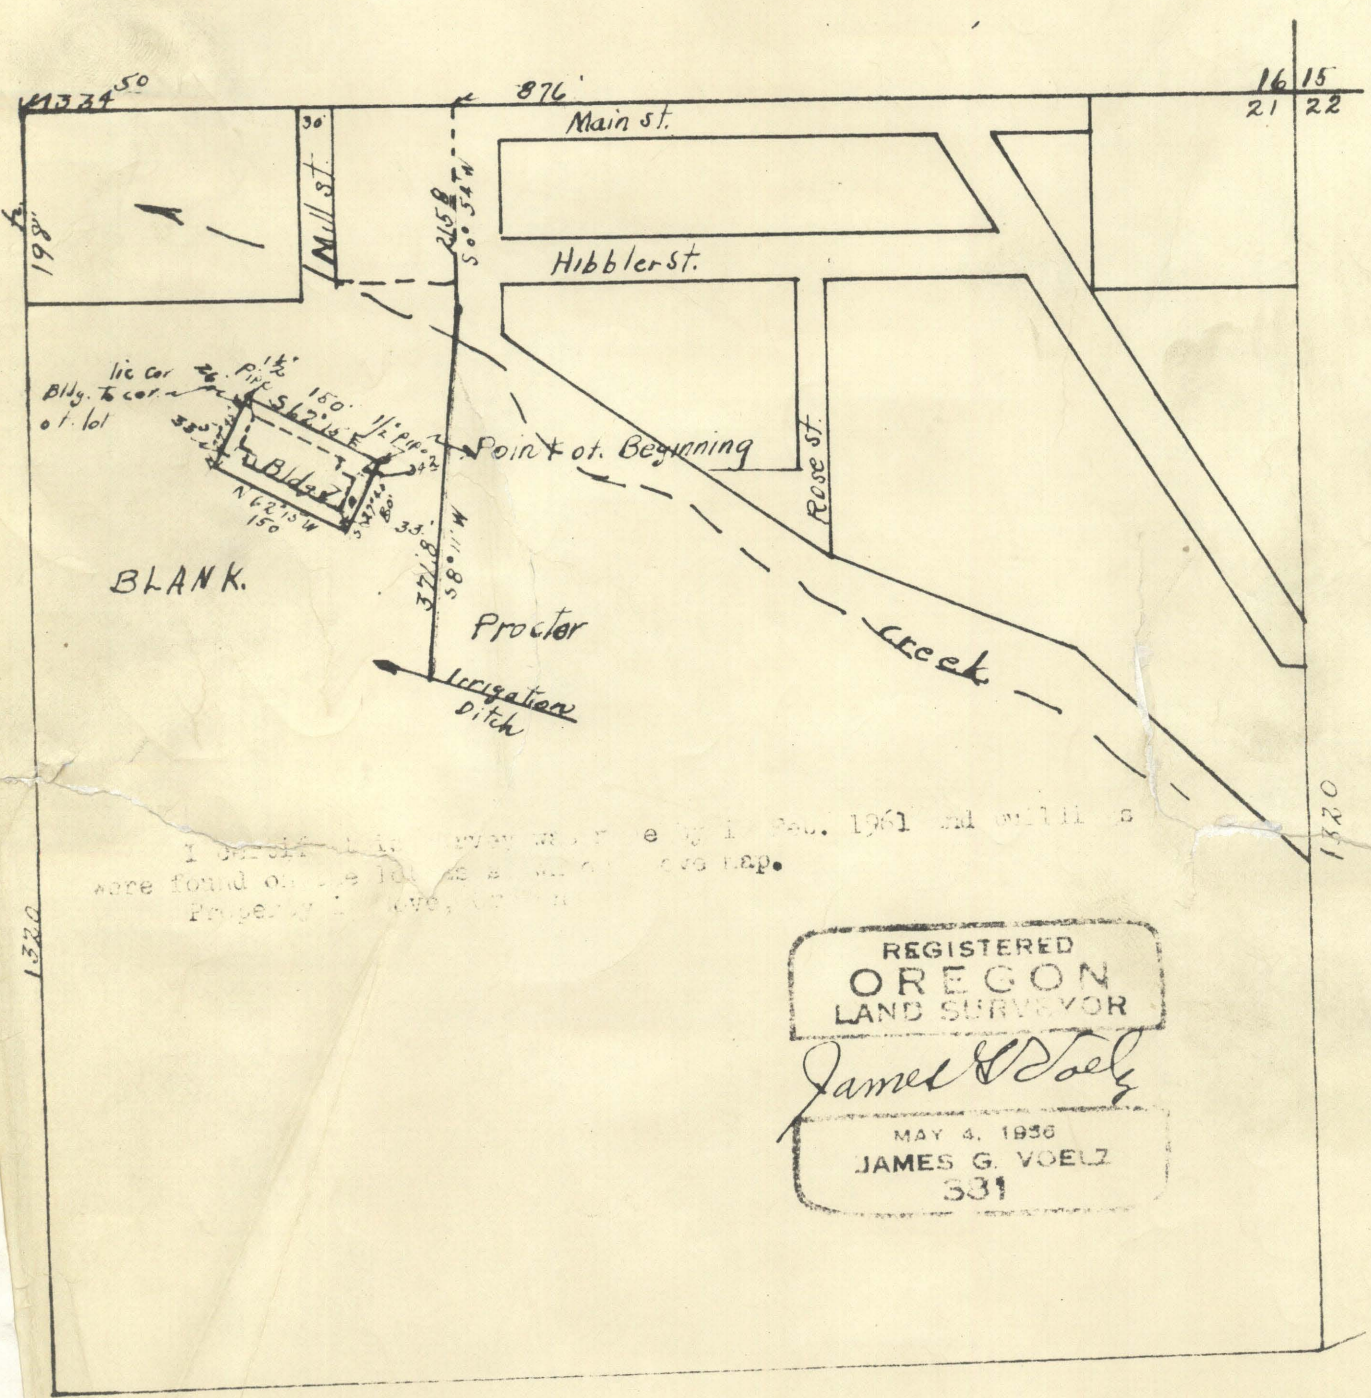


REGISTERED
 OREGON
 LAND SURVEYOR
James G. Voelz
 MAY 4, 1956
 JAMES G. VOELZ
 331

32-64

32-1964