


36-64

36-64

Survey for Bill Goss
1718 Alder
La Grande, Oregon

Date May 18, 1964

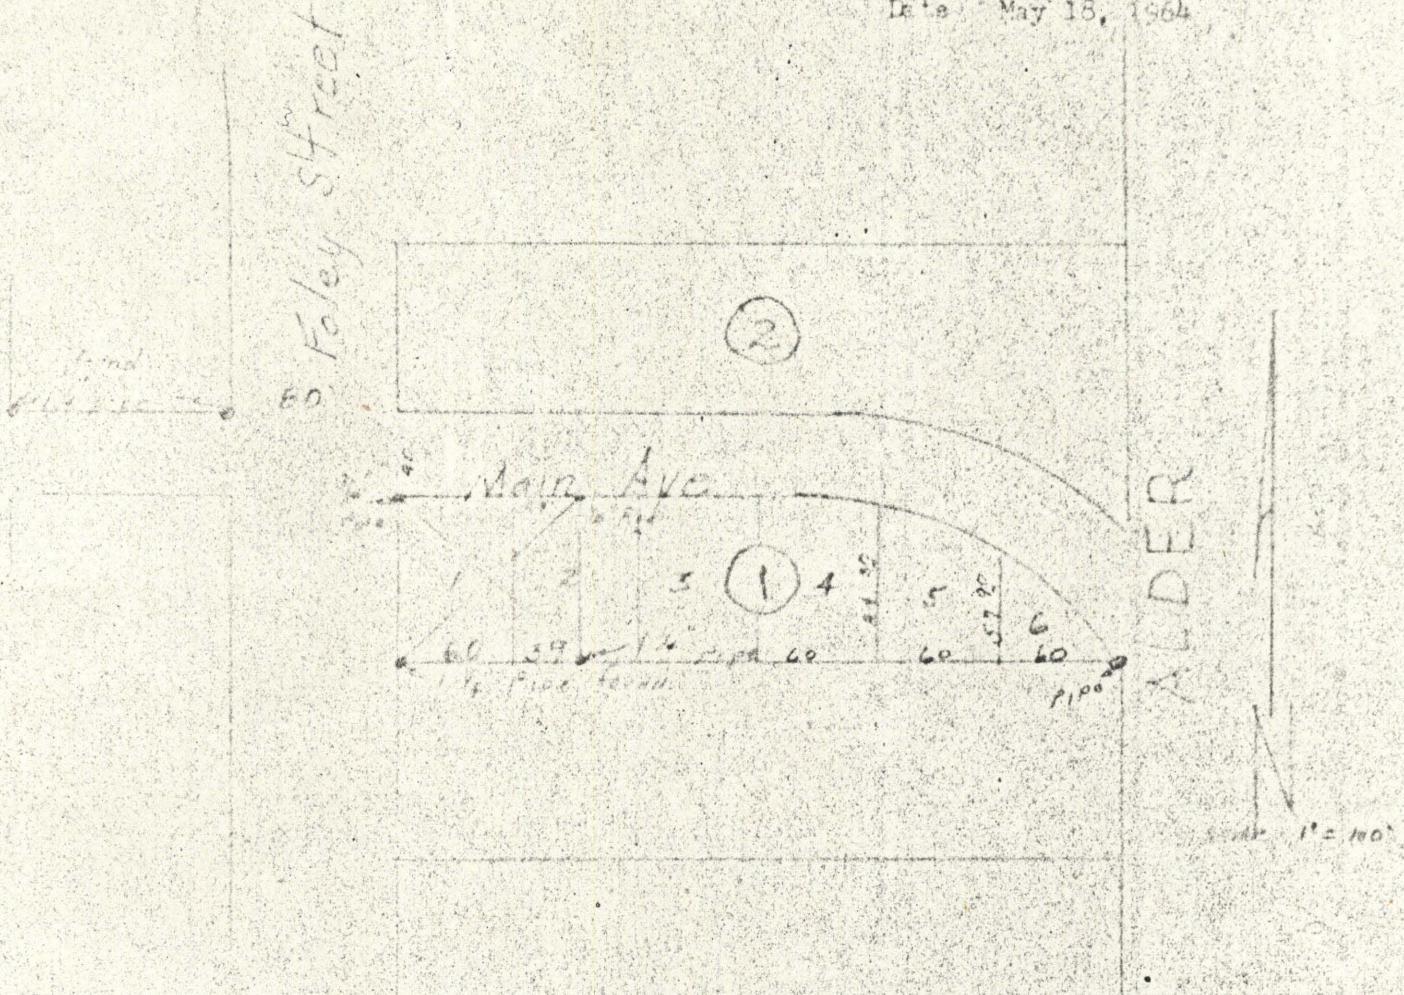

Description:
All of Lot #1 and west 39 ft. of Lot #2 of Block 1 of Foley Addition
to La Grande, Union County, Oregon

REGISTERED
OREGON
LAND SURVEYOR

James G. Voeltz

MAY 4, 1956
JAMES G. VOELTZ
331

36-1964