

45-164

45-164

Survey for Greenwell Hotel
305 Adams Ave.
La Grande, Oregon

Description: Lots 1 thru 8

of Block 14 of Grandy's
Second Addition to La Grande,
Oregon.


I certify this survey was
made by me on July 25, 1935,
and there are no encroachments
on adjoining property nor
does the surveyed property
overlap onto adjoining
property.

REGISTERED
OREGON
LAND SURVEYOR


James G. Voelz

MAY 4, 1935
JAMES G. VOELZ
381

Wall of adjoining Motel
one ft. in clear.

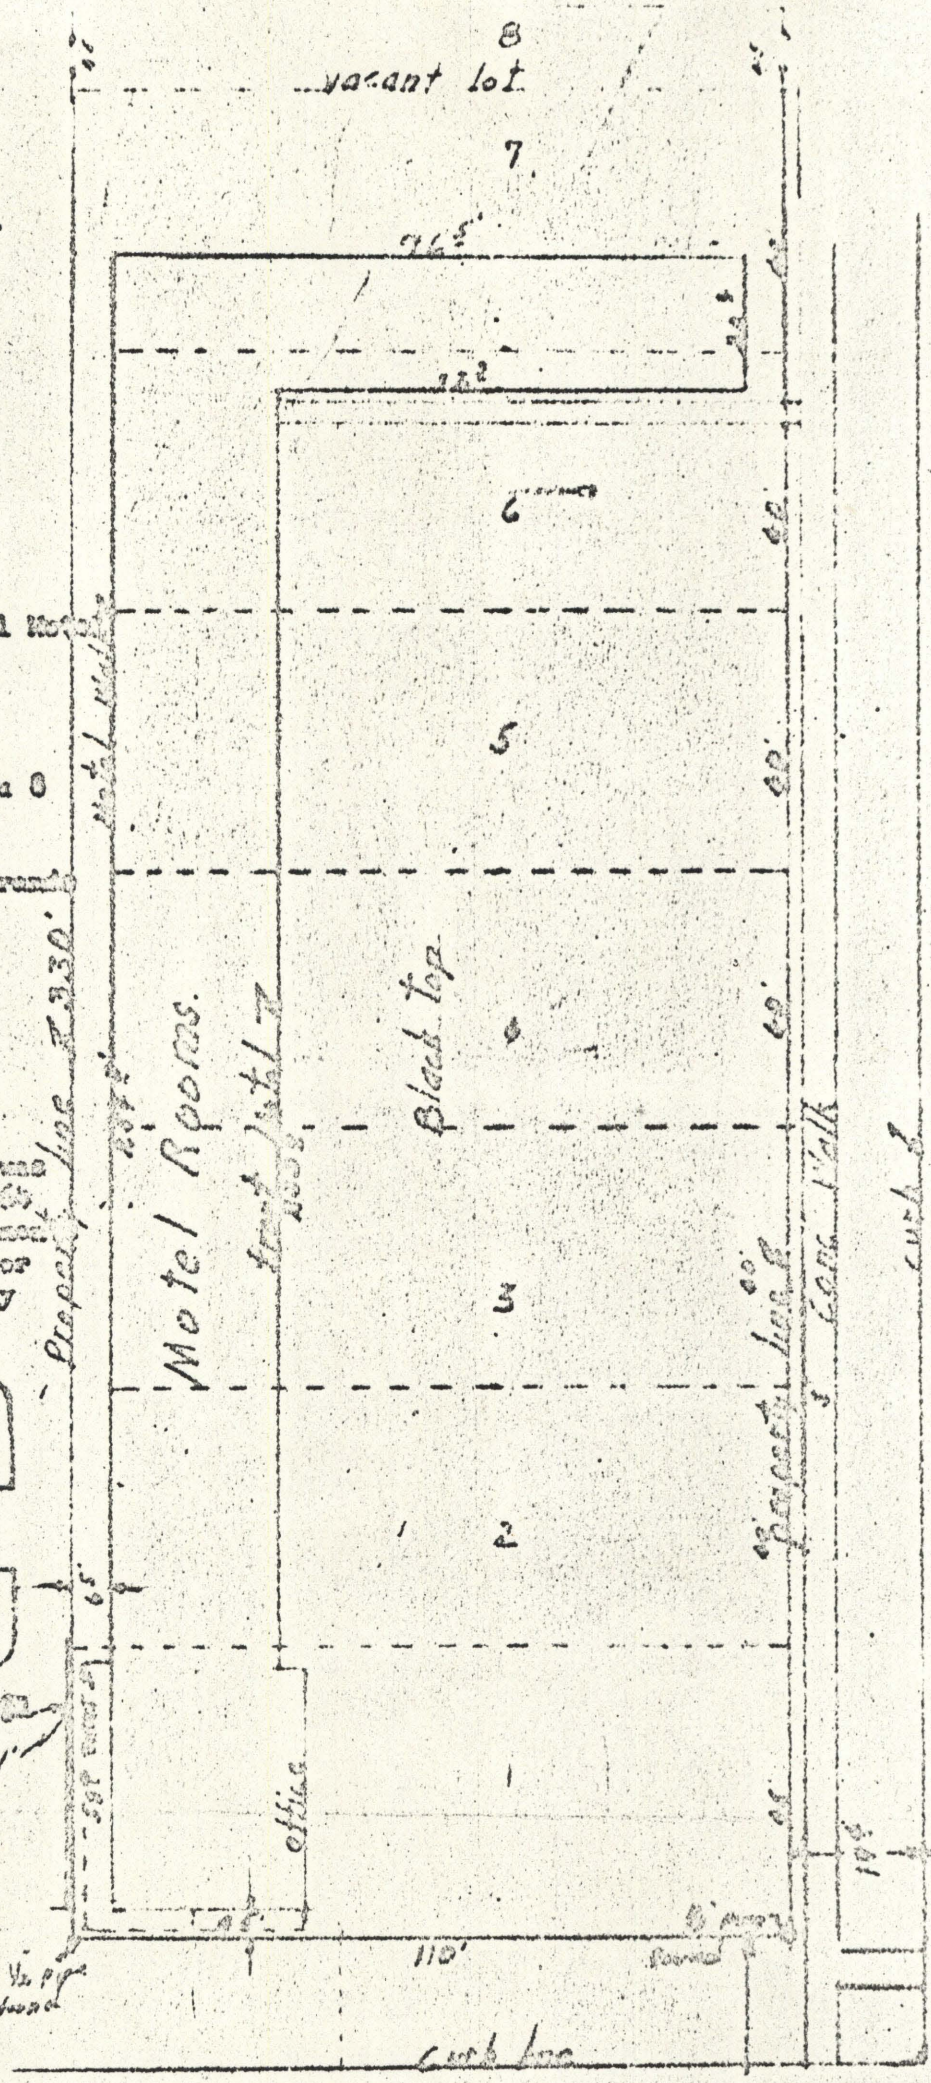

of Adams Ave

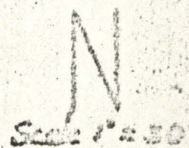

vacant lot

45-164