

48-64

48-64

Survey for Robert Briss
191^{1/2} East Penn


Date: July 22, 1964

La Grande, Oregon
Description: Lots 1 and 2 of Block ⁴⁴ of Williamson's Addition
to La Grande, Oregon

(Gravel)

East Penn

Lot 2 Allocated

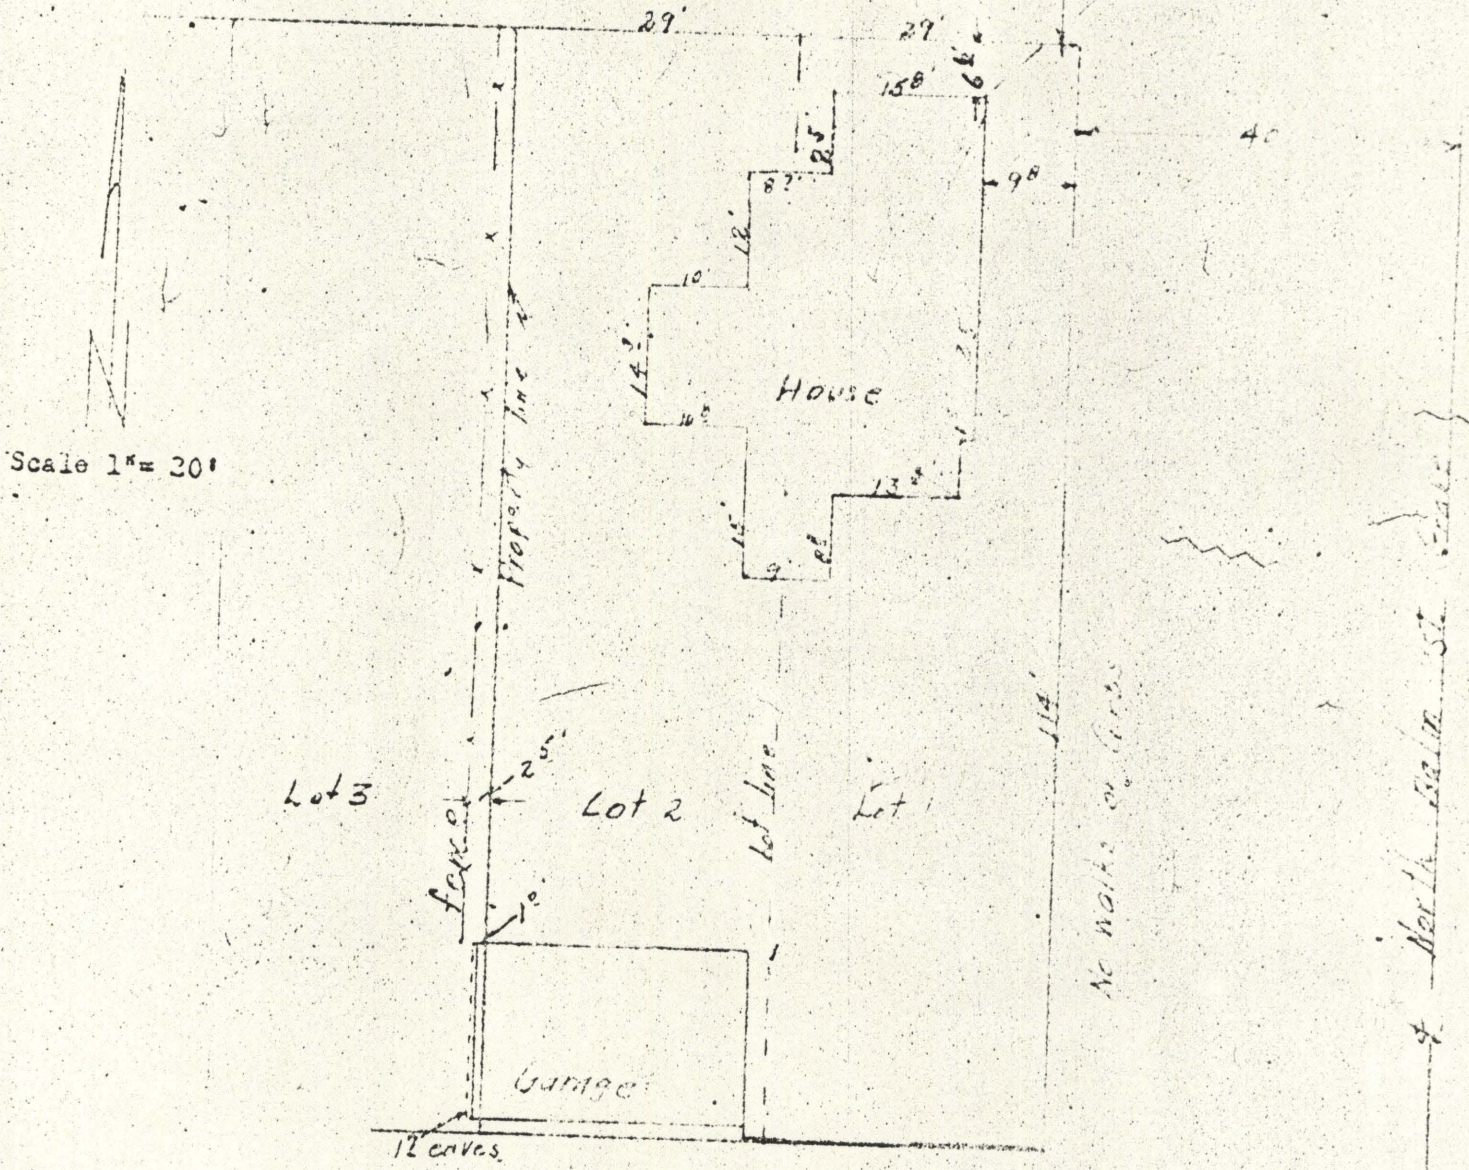

Scale 1" = 20'

I certify this survey was completed by me on July 22, 1964 and encroachments of surveyed property onto adjoining property to west is as noted. There is no encroachment of adjoining property onto surveyed property.

REGISTERED
SURVEYOR
LAND SURVEYOR

James H. [Signature]

48-1964