

4964


49-64

Survey for Willard Gray
107 S. Ave.
La Grande, Oregon

Survey date, November 3 and 4, 1964

C. House

Description: The Northeasterly 49.6 feet of Lot seven (7) and Southeasterly 50.6 feet of Lot six (6) all in Block Four (4) of Coggan's Addition to La Grande, Union County, Oregon according to the recorded plat of said addition.

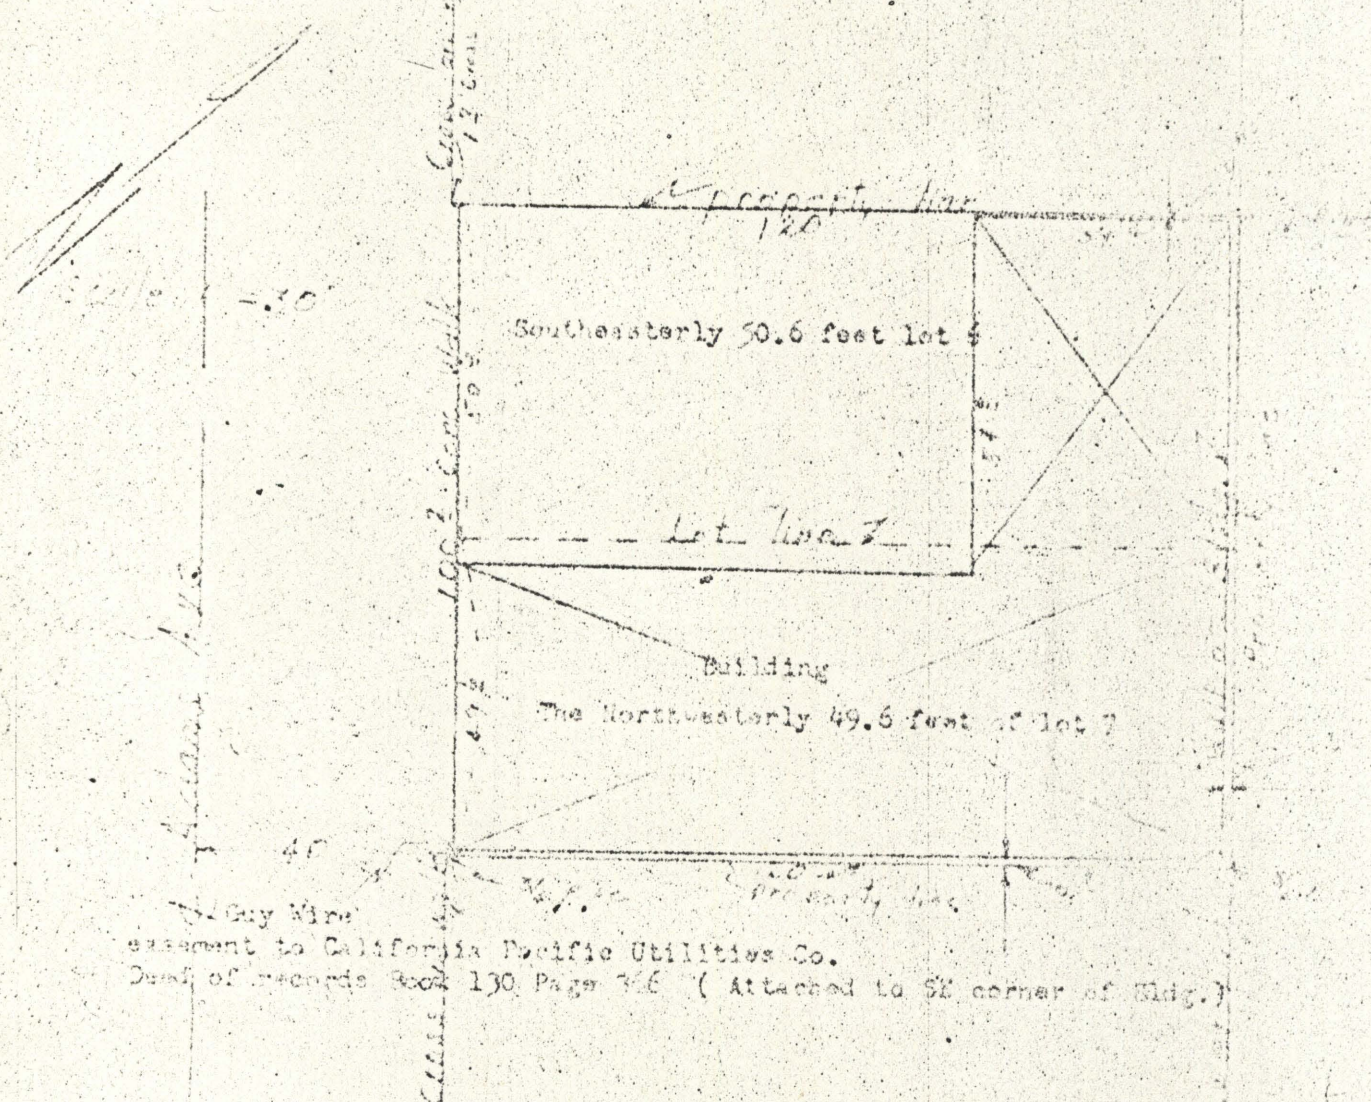

Guy Wire
attachment to California Pacific Utilities Co.
Deed of records Book 130 Page 366 (Attached to SE corner of Bldg.)

I certify this survey was completed by us on dates shown and there are no encroachments of adjoining property onto surveyed property nor does the surveyed property encroach onto adjoining land. There are records of assessments and recorded in Book 53 page 534 for Lot six and Book 53 page 145 for Lot 7 for a sewer line located as shown. Guy wire attachment assessed recorded in Book 130 Page 366 as shown.

JAMES M. WELCH
 State of Oregon
 License No. 1381

49-1964