


49-15

Survey for Duane Fleet  
La Grande, Oregon

June 18, 1961

Establish NE corner of SE<sub>1</sub> SE<sub>4</sub> Section 28, TAC-S, R-37-EW.

The original witness trees for 1/4 corner of SECTION 27 and 28 were found.  
The new markings were established as shown on the plat and steel shaft driven  
on the corner.

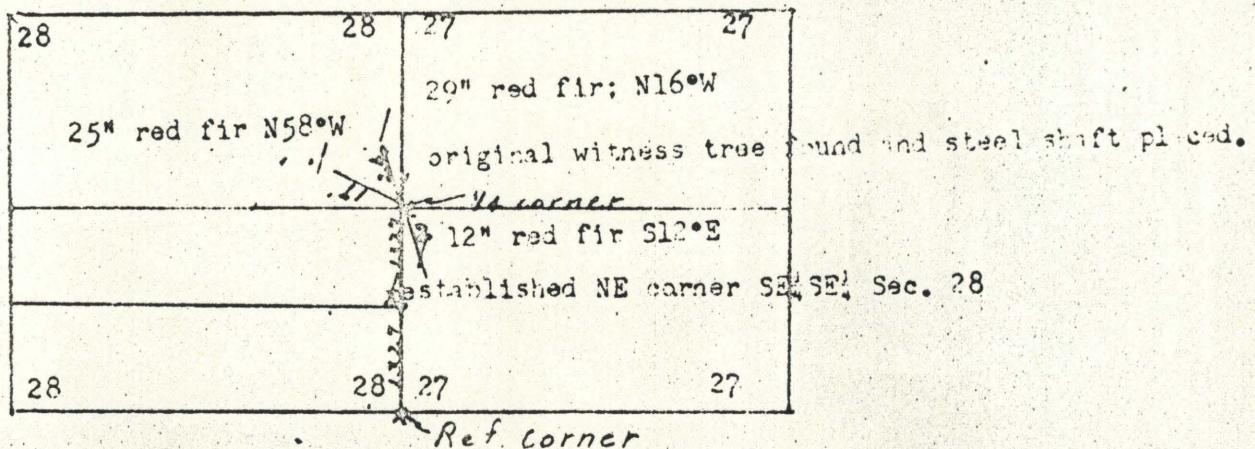

Scale 1:5200



#49-15-1