


54-64

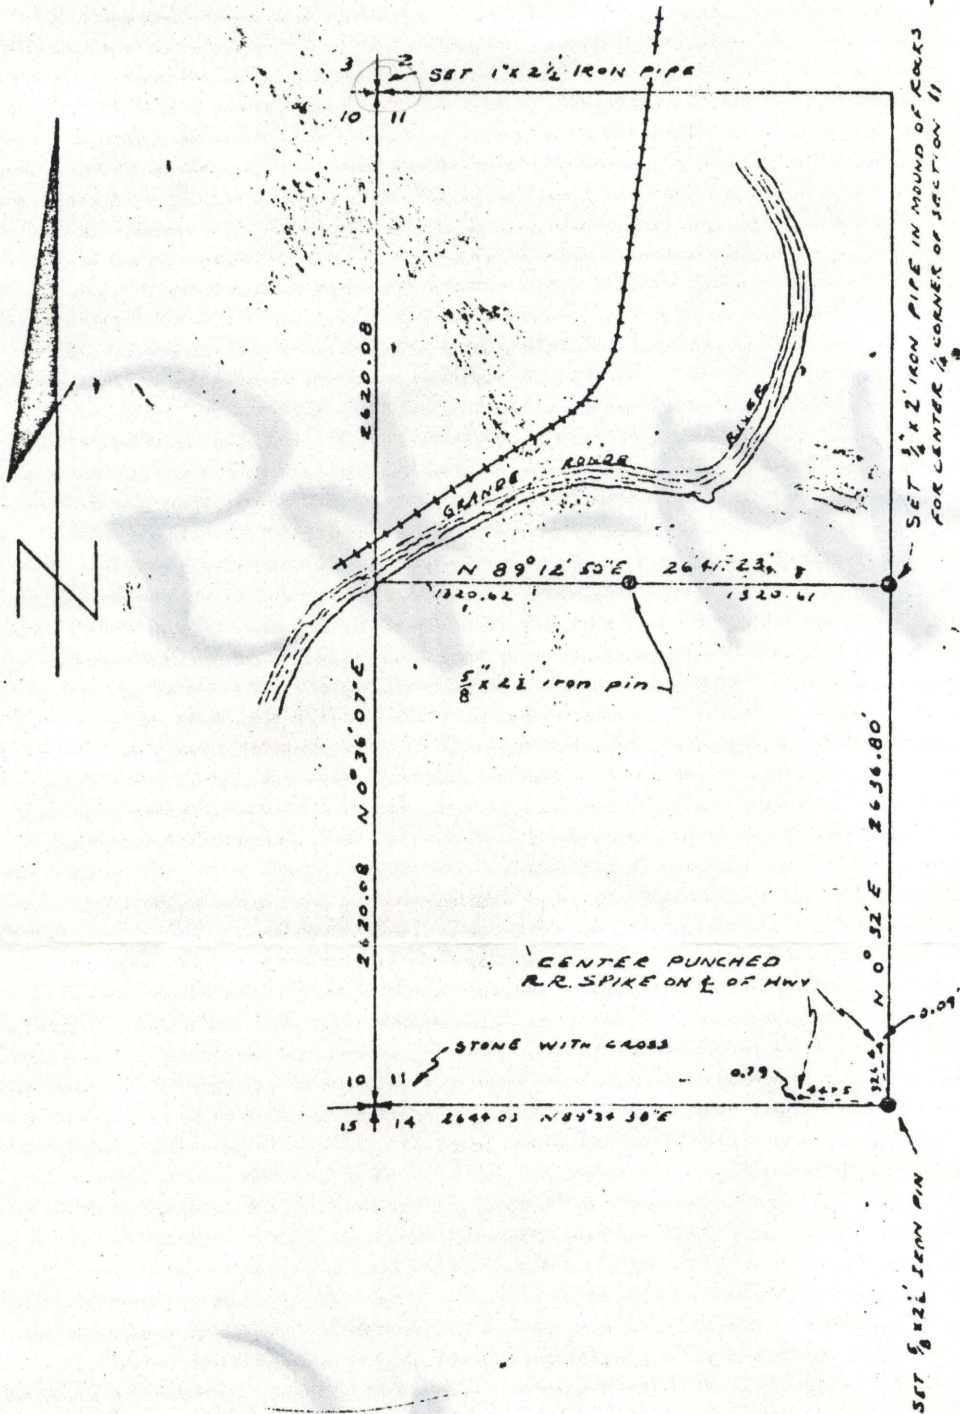

UNION COUNTY SURVEYOR

Date Received _____

Date Filed 1-15-87

By G. LANGLITZ, Deputy

File No. 54-64

PROJECT: ELGIN SANITARY SEWERS

SUBDIVISIONAL SURVEY OF THE WEST HALF OF SECTION 11 TWN. 1 N., R39 E. W.M

DR. BY: <u>OLS</u>	DATE: <u>Nov 2 1964</u>	SCALE: <u>1" = 100'</u>
CK. BY: _____	REV: _____	SHEET _____ OF _____

STANLEY G. WALLULIS
 Consulting Engineer
 P. O. Box 91
 213 S. W. Emigrant

Pendleton Oregon

54-64