


65-9  
9-65

59-6

Survey for  
Philip C Graue  
501 M Ave.  
La Grande, Oregon

Date June 21, 1965

Description:  
All of lot 2 of Block A of Wisdom's Addition to La Grande, Oregon.

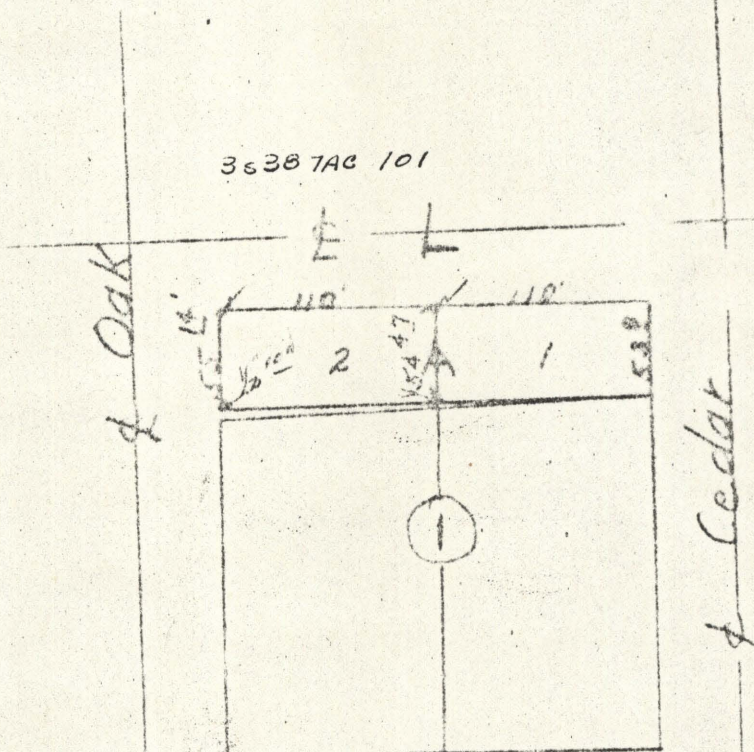

REGISTERED  
OREGON  
LAND SURVEYOR

*James G. Voelz*

MAY 4, 1956  
JAMES G. VOELZ  
381