14-65

59-41

Survey for
Wm. Jeffers
Island City Highway
La Grande, Oregon

Date June, 1965

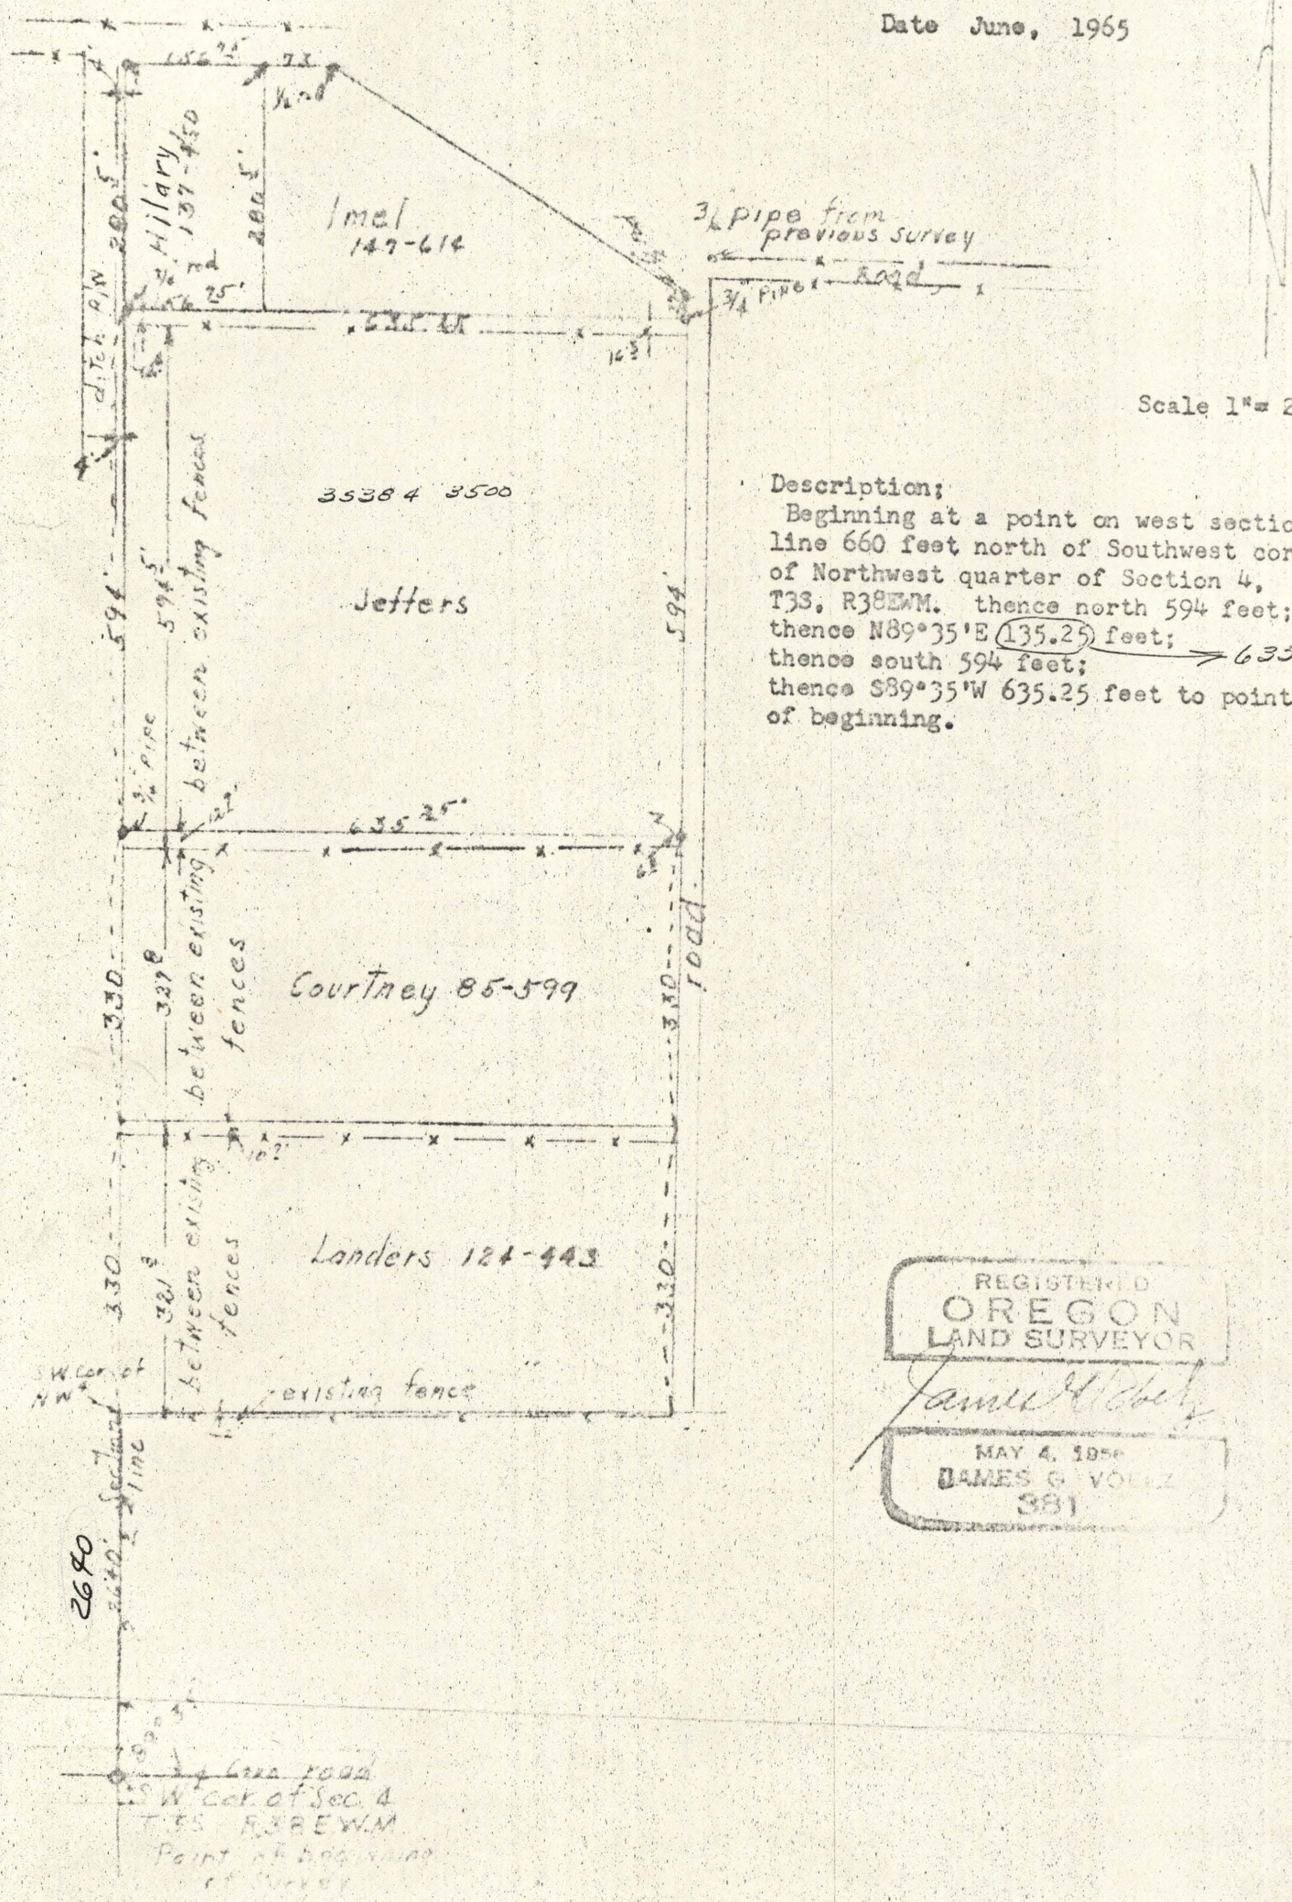

Description;
Beginning at a point on west section line 660 feet north of Southwest corner of Northwest quarter of Section 4, T3S, R38EWM. thence north 594 feet; thence N89°35'E 135.25 feet; → 635.25 ft
thence south 594 feet;
thence S89°35'W 635.25 feet to point of beginning.

REGISTERED
OREGON
LAND SURVEYOR
James G. Voelz
MAY 4, 1956
JAMES G. VOELZ
381